


#GV_PER_000	Index
#GV_PER_600	Ceiling Support Rails
#GV_PER_602	Ceiling Support Rails - Plate Plan Detail
#GV_PER_603	Ceiling Support Rails - Plate Elevation
#GV_PER_604	Face Fix Double Joist 190mm 1m Residential Barrier 24
#GV_PER_605	Face Fix Concrete 1m Residential Barrier
#GV_PER_606	Ceiling Support Vertical Rails Rails
#GV_PER_607	Face Fix 190mm Double Joist 1m Residential Barrier
#GV_PER_607b	Face Fix 190 Double Joist 1m Residential Barrier Elevation
#GV_PER_608	Top Fix 190 Triple Joist 1m Residential Barrier
#GV_PER_608b	Top Fix 190 Triple Joist 1m Residential Barrier Plan
#GV_PER_609	Connections
#GV_PER_610	Top Fix 190 Triple Joist
#GV_SCR_601	Screen Connection
#GV_SCR_601a	Screen Connection Detail
#GV_SCR_602b	Typical Fixing Detail For Louvre Screens
#GV_SCR_603	Screen Gable
#GV_SCR_604	Screen Connection - Brick Veneer
GV_PER_100	Pergola
GV_PER_110	Pergola Plan
GV_PER_120	Pergola
GV_PER_130	Pergola Section
GV_PER_200	Vertical Rail
GV_PER_210	Vertical Rail Plan
GV_PER_220	Vertical Rail - Elevations
GV_PER_230	Vertical Rail - Section
GV_PER_300	Ceiling Rails
GV_PER_310	Ceiling Rails - Plan
GV_PER_320	Ceiling Rails
GV_PER_330	Ceiling Rails - Section
GV_PER_400	Gable Screen
GV_PER_410	Gable Screen
GV_PER_420	Gable Screen - Elevation
GV_PER_430	Gable Screen - Section
GV_SCR_700	Screen Frame
GV_SCR_710	Screens 65x16 Vertical
GV_SCR_720	Screens 70x30 Vertical
GV_SCR_730	Screens 100x50 Vertical
GV_SCR_740	Screens 150x50 Vertical
GV_SCR_810	Screens 65x16 Horizontal
GV_SCR_820	Screens 70x30 Horizontal
GV_SCR_830	Screens 100x50 Horizontal
GV_SCR_840	Screens 150x50 Horizontal

Grand total: 43

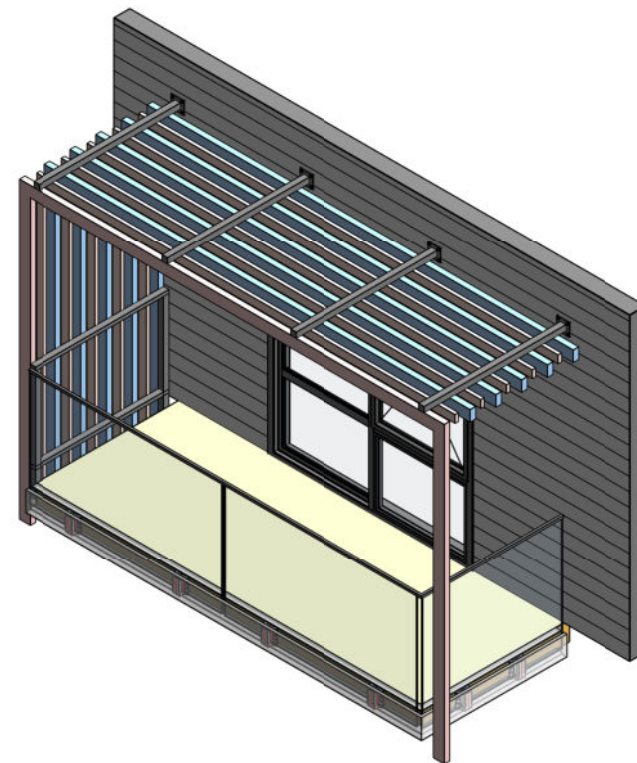

These drawings relate only to the Glass Vice Floating Timber Deck framing and its fixings. All other elements are shown indicative only.

© 2021. The copyright of this document is the property of Glass Vice Limited and shall not be reproduced, copied, loaned or disposed of directly, or indirectly, nor used for any purpose other than that for which it is specifically furnished without prior consent.



# Glass Vice Pergolas and Screens

Pergola

Index


gv\_pergola\_ktald.rvt  
All dimensions in millimetres

Date: Nov 2021  
Scale:  
Draft E


Quick Code:

www.glassvice.com  
Phone +64 9 414 6565  
info@glassvice.com

#GV\_PER\_000

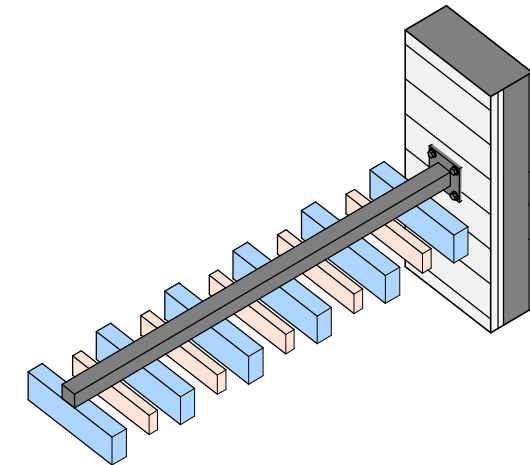

1 #gv\_per\_600 ceiling support rails\_1

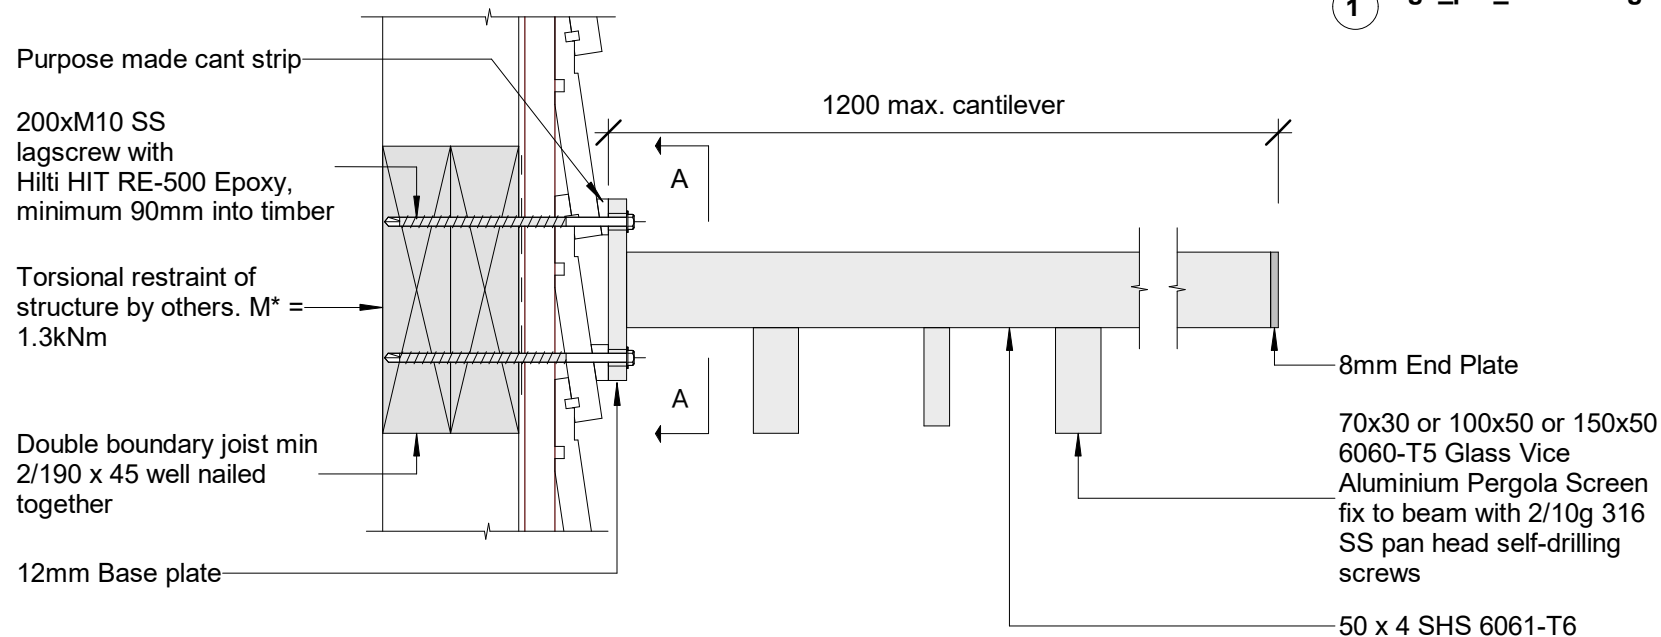

2 #gv\_per\_600 ceiling support rails\_2  
1 : 5

These drawings relate only to the Glass Vice Floating Timber Deck framing and its fixings. All other elements are shown indicative only.

© 2021. The copyright of this document is the property of Glass Vice Limited and shall not be reproduced, copied, loaned or disposed of directly, or indirectly, nor used for any purpose other than that for which it is specifically furnished without prior consent.



# Glass Vice Pergolas and Screens

Pergola  
Ceiling Support Rails


Date: Nov 2021  
Scale: 1 : 5  
Draft E

Quick Code:

gv\_pergola\_ktald.rvt  
All dimensions in millimetres

www.glassvice.com  
Phone +64 9 414 6565  
info@glassvice.com

#GV\_PER\_600

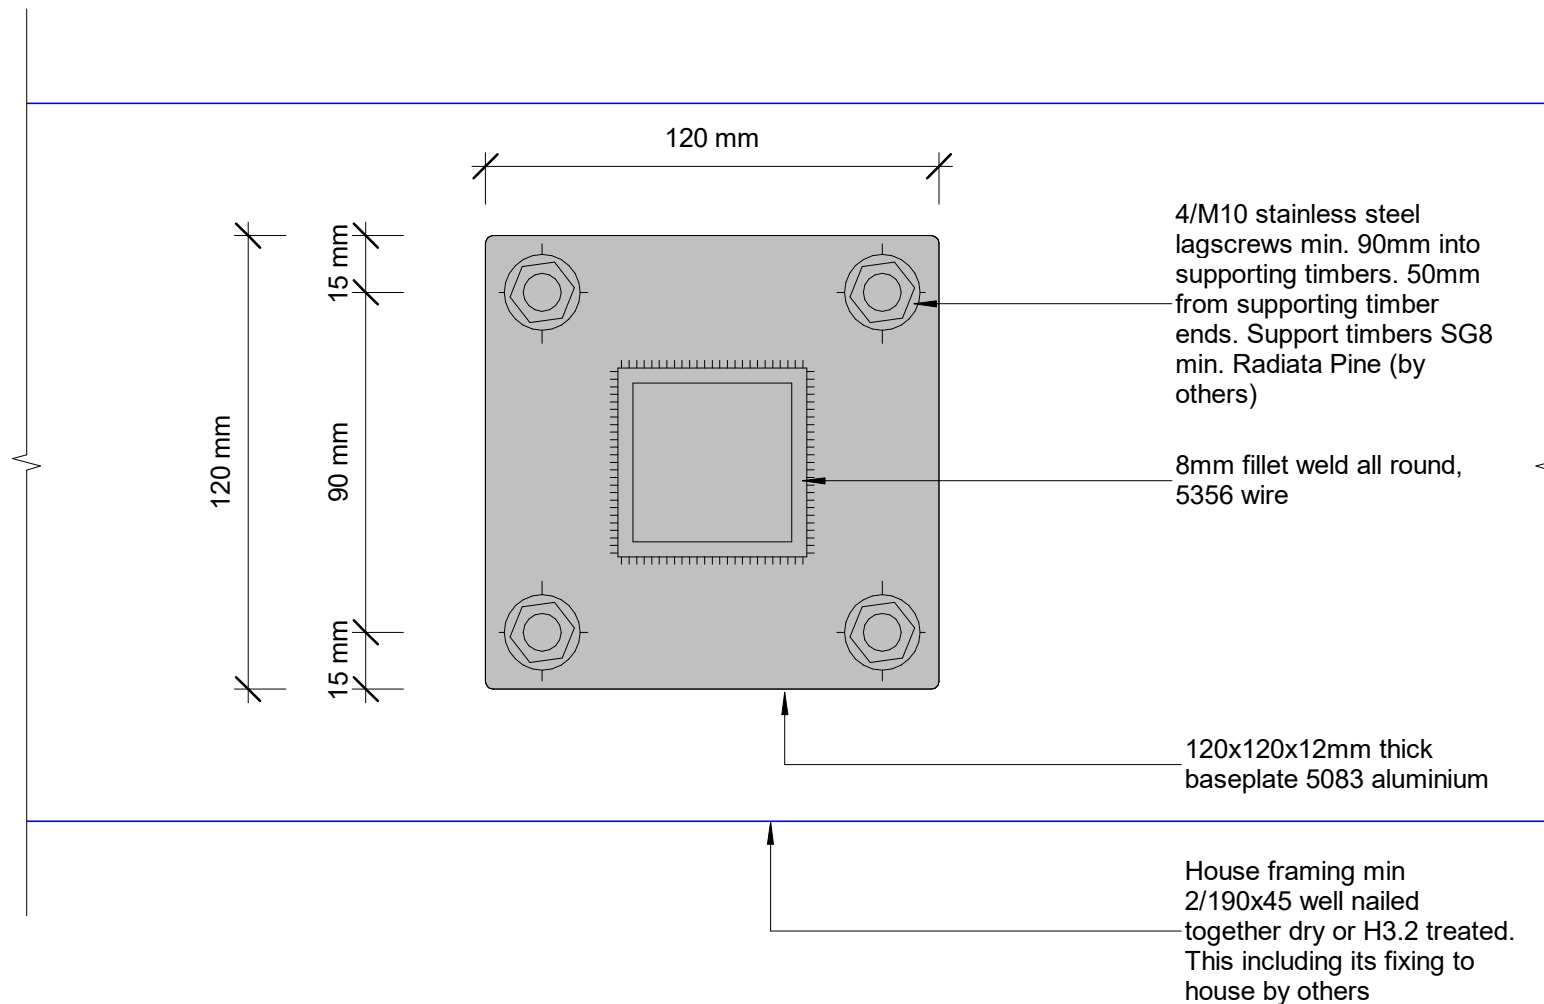

These drawings relate only to the Glass Vice Floating Timber Deck framing and its fixings. All other elements are shown indicative only.

© 2021. The copyright of this document is the property of Glass Vice Limited and shall not be reproduced, copied, loaned or disposed of directly, or indirectly, nor used for any purpose other than that for which it is specifically furnished without prior consent.

gv\_pergola\_ktalt.d.rvt  
All dimensions in millimetres



# Glass Vice Pergolas and Screens

Pergola


Ceiling Support Rails - Plate Plan Detail

Date: Nov 2021  
Scale: 1 : 2  
Draft E

Quick Code:

www.glassvice.com  
Phone +64 9 414 6565  
info@glassvice.com

#GV\_PER\_602

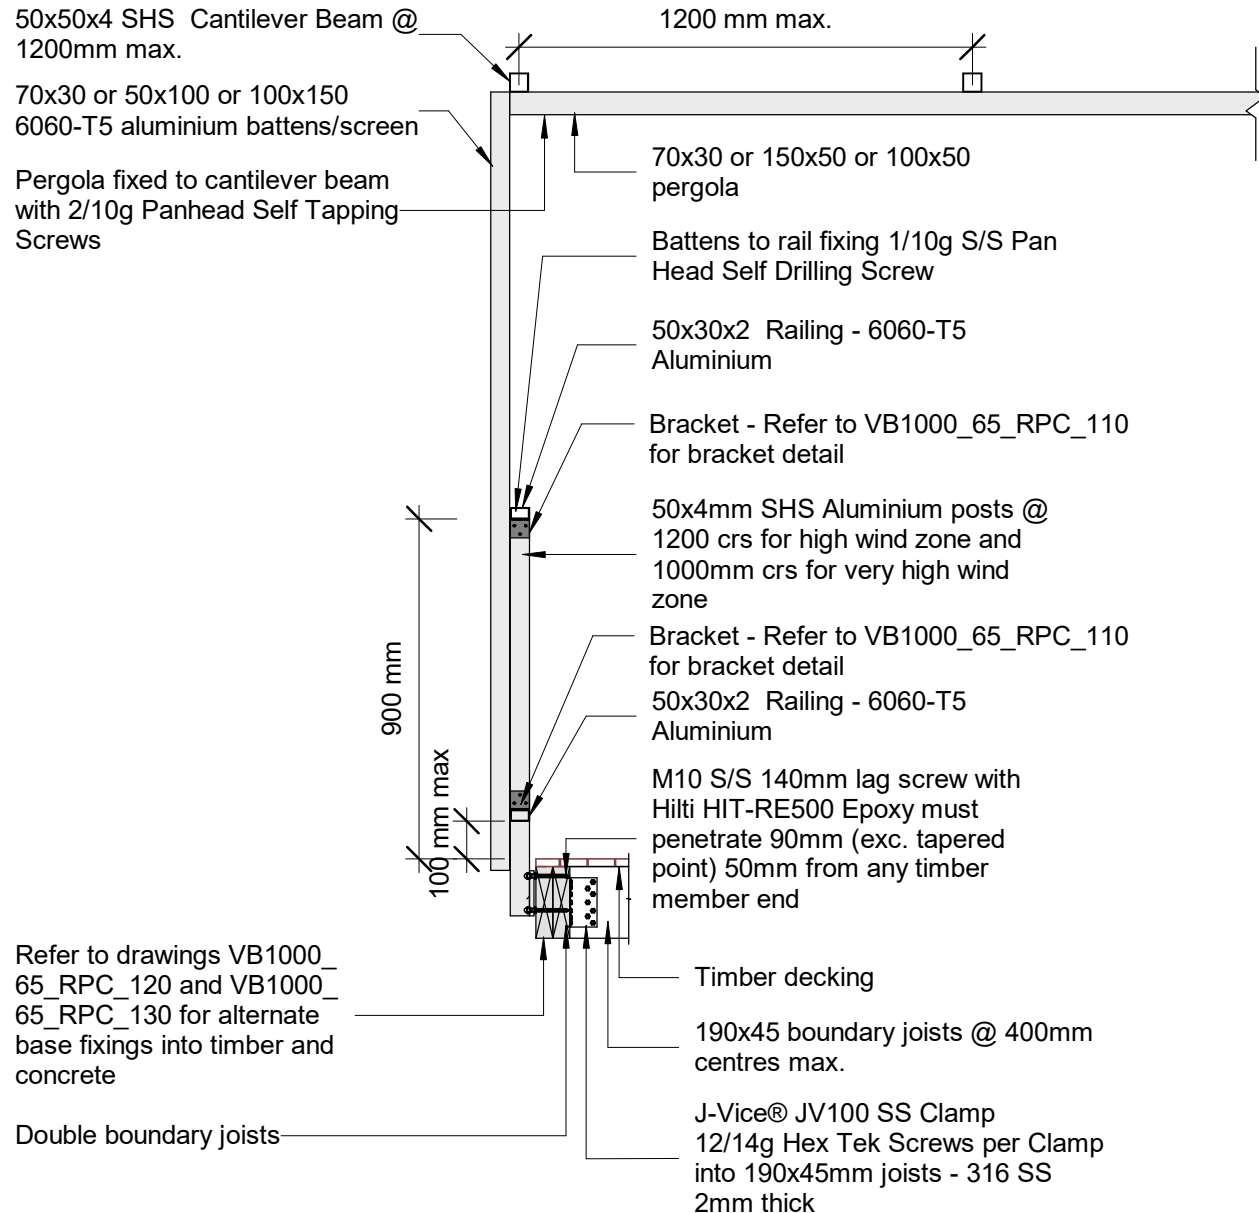

These drawings relate only to the Glass Vice Floating Timber Deck framing and its fixings. All other elements are shown indicative only.

© 2021. The copyright of this document is the property of Glass Vice Limited and shall not be reproduced, copied, loaned or disposed of directly, or indirectly, nor used for any purpose other than that for which it is specifically furnished without prior consent.

gv\_pergola\_ktald.rvt  
All dimensions in millimetres



# Glass Vice Pergolas and Screens

Pergola


Ceiling Support Rails - Plate Elevation

Date: Nov 2021  
Scale: 1 : 20  
Draft E

Quick Code:

www.glassvice.com  
Phone +64 9 414 6565  
info@glassvice.com

#GV\_PER\_603

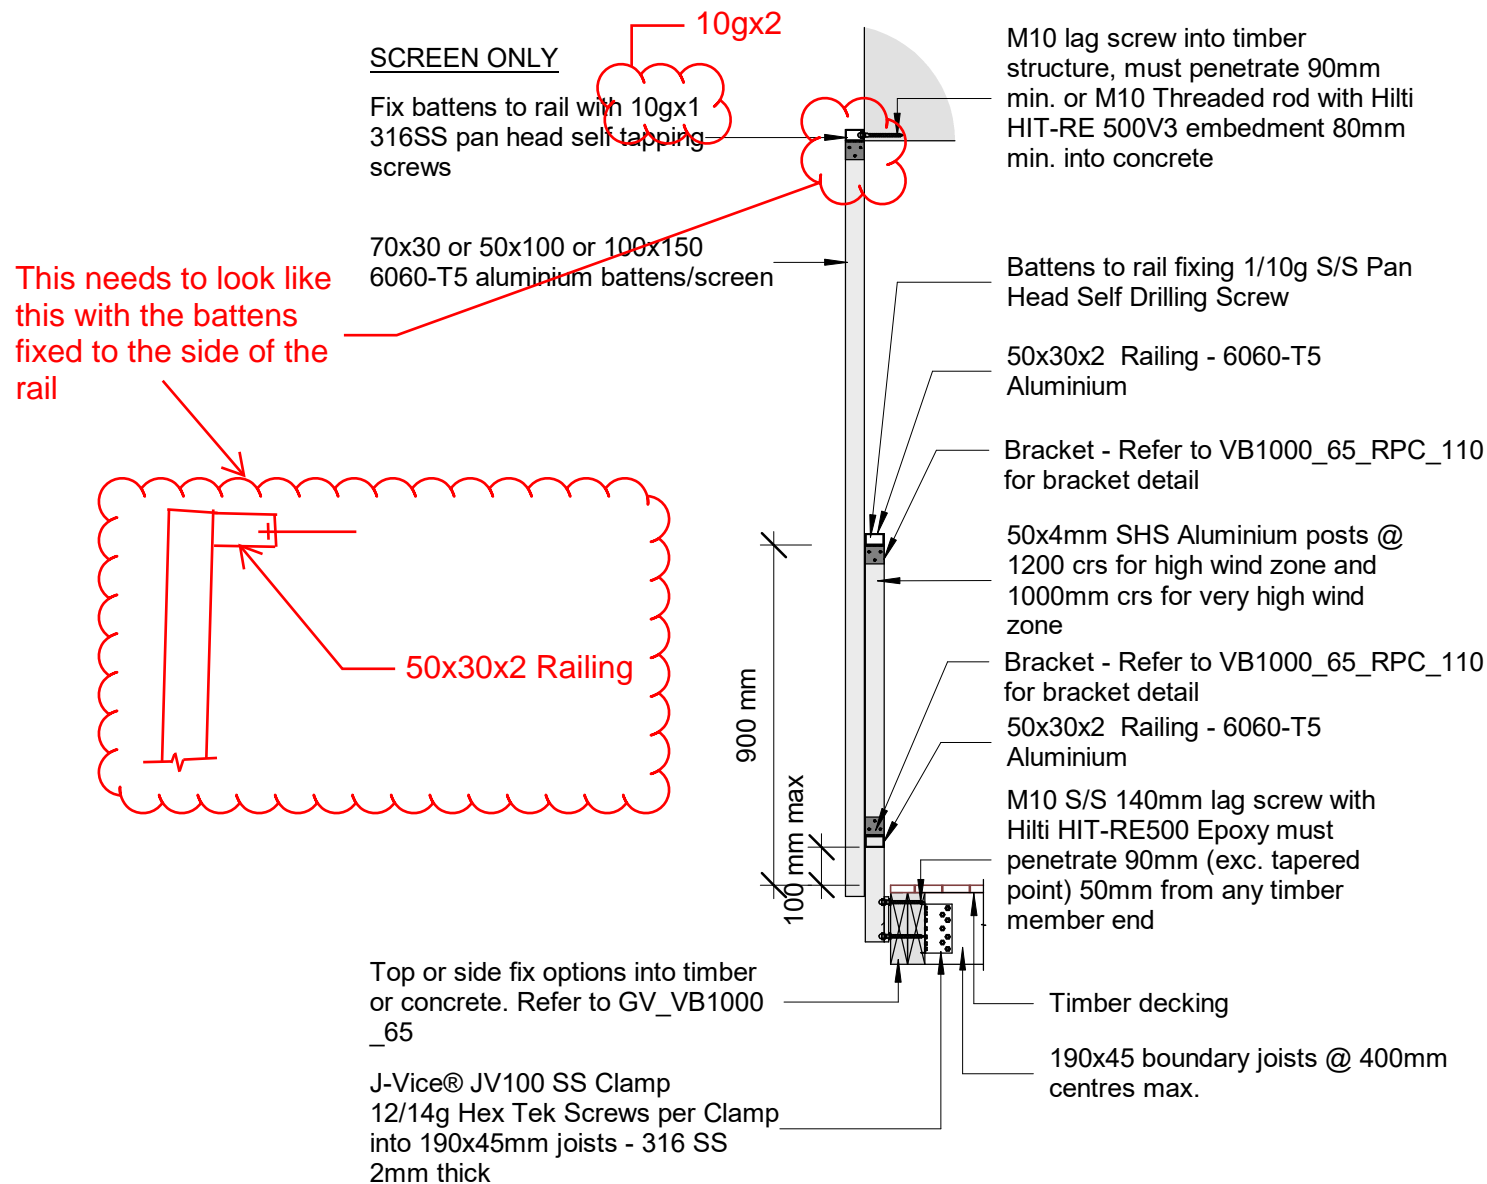

These drawings relate only to the Glass Vice Floating Timber Deck framing and its fixings. All other elements are shown indicative only.

© 2021. The copyright of this document is the property of Glass Vice Limited and shall not be reproduced, copied, loaned or disposed of directly, or indirectly, nor used for any purpose other than that for which it is specifically furnished without prior consent.

gv\_pergola\_ktaldt.rvt  
All dimensions in millimetres



**#GV\_PER\_606**

50x4mm SHS Aluminium posts  
6061-T6 @1000mm crs max. for  
very high wind zone. Posts  
@1200mm crs max. for high wind  
zone.

100 mm max. from F.F.L.  
to first fastener

120mm long 6mm fillet weld (leg  
size, equal) each side of post 5356  
filler alloy

Supporting structure design by  
others. Supporting timber to resist  
1.64kNm moment

4/M10 stainless steel lagscrews  
min. 90mm into supporting timbers  
with Hilti HIT-RE 500 Epoxy.  
50mm from supporting timber  
ends. Support timbers SG8 min.  
Radiata Pine

12mm plate 5083-H321, H116  
Alloy aluminium

Timber decking

F.F.L

25 mm min.

90 mm

25 mm min.

12 mm

These drawings relate only to the Glass Vice Floating Timber Deck framing and its fixings. All other elements are shown indicative only.

© 2021. The copyright of this document is the property of Glass Vice Limited and shall not be reproduced, copied, loaned or disposed  
of directly, or indirectly, nor used for any purpose other than that for which it is specifically furnished without prior consent.

gv\_pergola\_ktald.rvt  
All dimensions in millimetres

**GLASS VICE®**

## Glass Vice Pergolas and Screens

Pergola

Face Fix 190mm Double Joist 1m Residential Barrier


Date: Nov 2021  
Scale: 1 : 2  
Draft E

Quick Code:

www.glassvice.com  
Phone +64 9 414 6565  
info@glassvice.com

#GV\_PER\_607



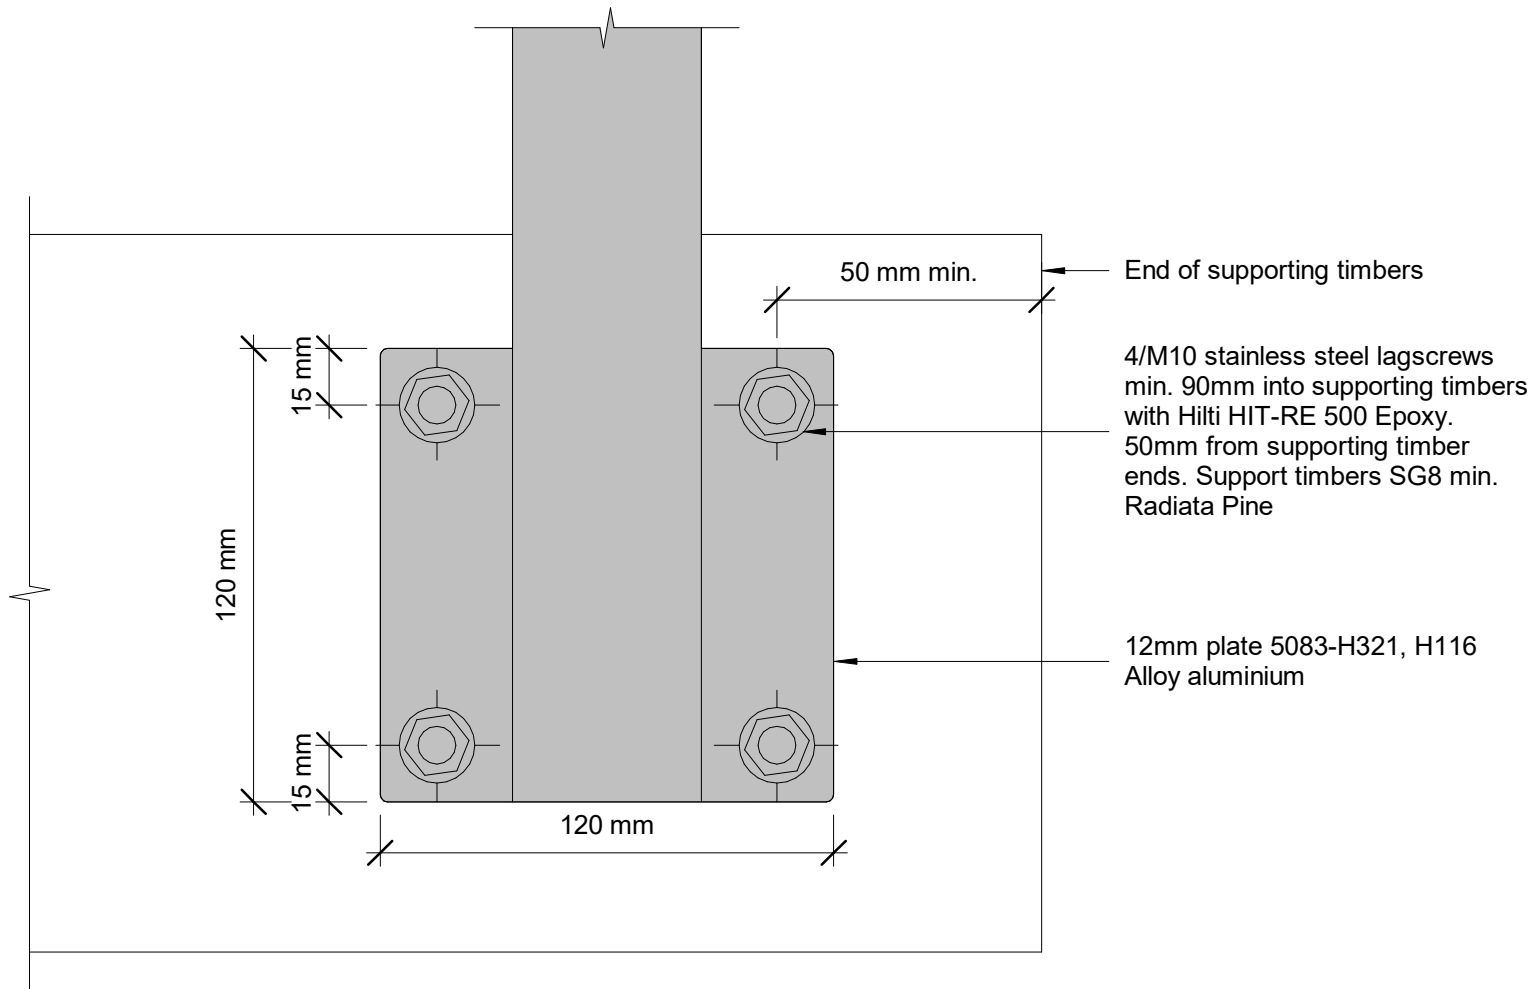

These drawings relate only to the Glass Vice Floating Timber Deck framing and its fixings. All other elements are shown indicative only.

© 2021. The copyright of this document is the property of Glass Vice Limited and shall not be reproduced, copied, loaned or disposed of directly, or indirectly, nor used for any purpose other than that for which it is specifically furnished without prior consent.

gv\_pergola\_ktaldt.rvt  
All dimensions in millimetres



# Glass Vice Pergolas and Screens

Pergola


Face Fix 190 Double Joist 1m Residential Barrier Elevation

Date: Nov 2021  
Scale: 1 : 2  
Draft E

Quick Code:

www.glassvice.com  
Phone +64 9 414 6565  
info@glassvice.com

#GV\_PER\_607b

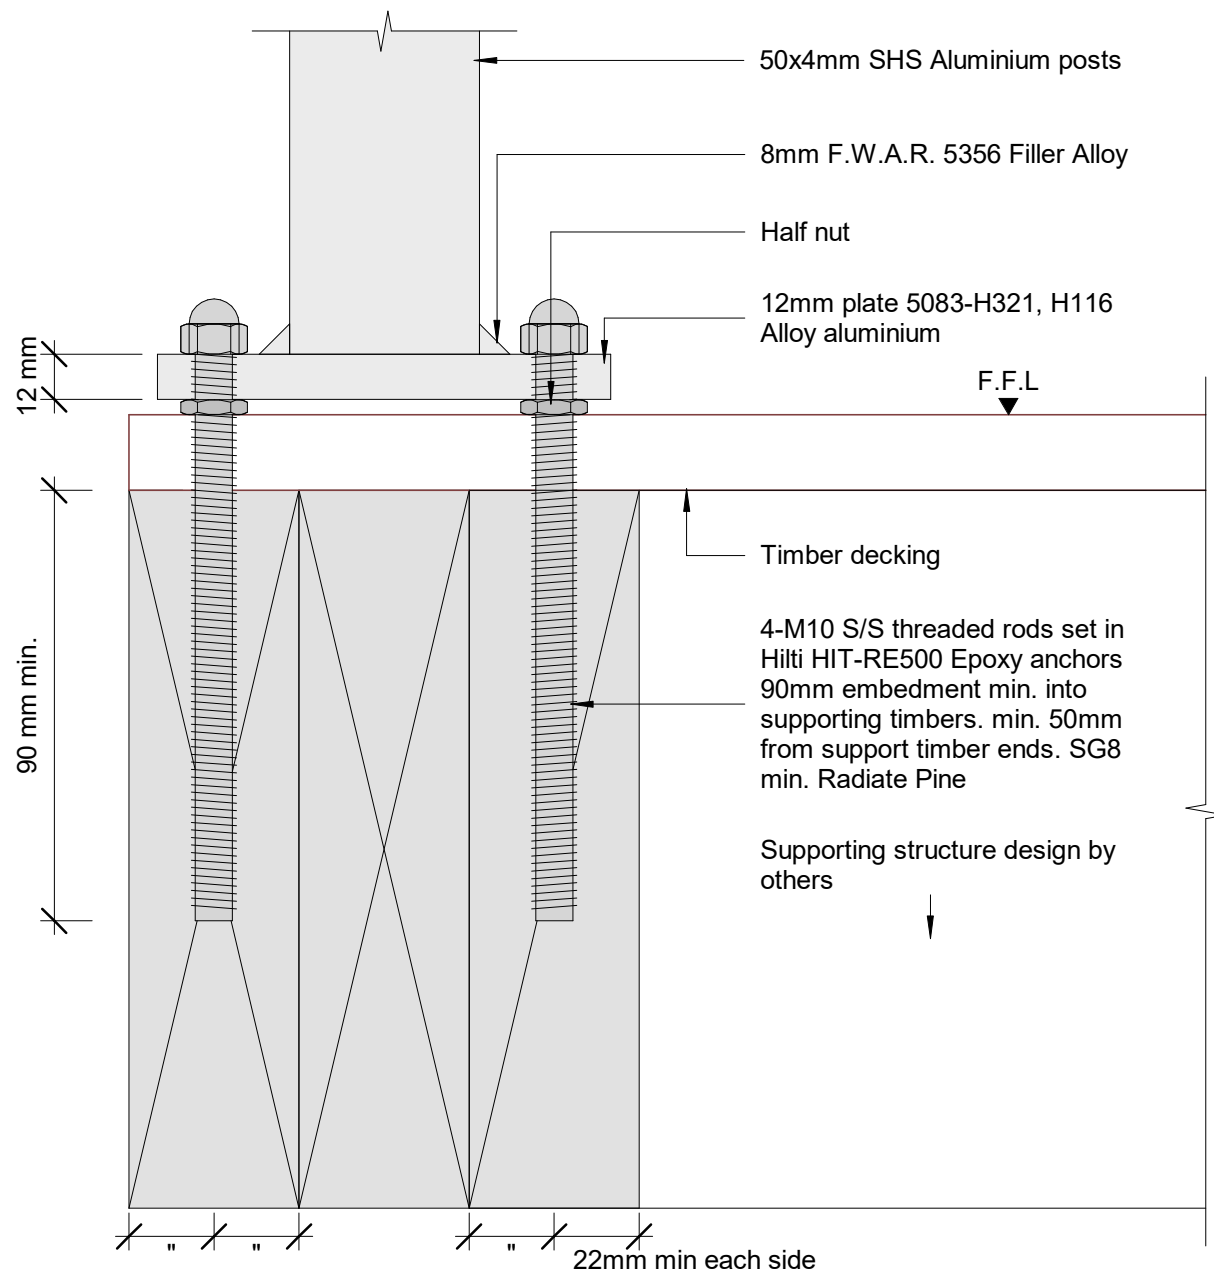

These drawings relate only to the Glass Vice Floating Timber Deck framing and its fixings. All other elements are shown indicative only.

© 2021. The copyright of this document is the property of Glass Vice Limited and shall not be reproduced, copied, loaned or disposed of directly, or indirectly, nor used for any purpose other than that for which it is specifically furnished without prior consent.

gv\_pergola\_ktaldt.rvt  
All dimensions in millimetres



# Glass Vice Pergolas and Screens

Pergola


Top Fix 190 Triple Joist 1m Residential Barrier

Date: Nov 2021  
Scale: 1 : 2  
Draft E

Quick Code:

www.glassvice.com  
Phone +64 9 414 6565  
info@glassvice.com



#GV\_PER\_608

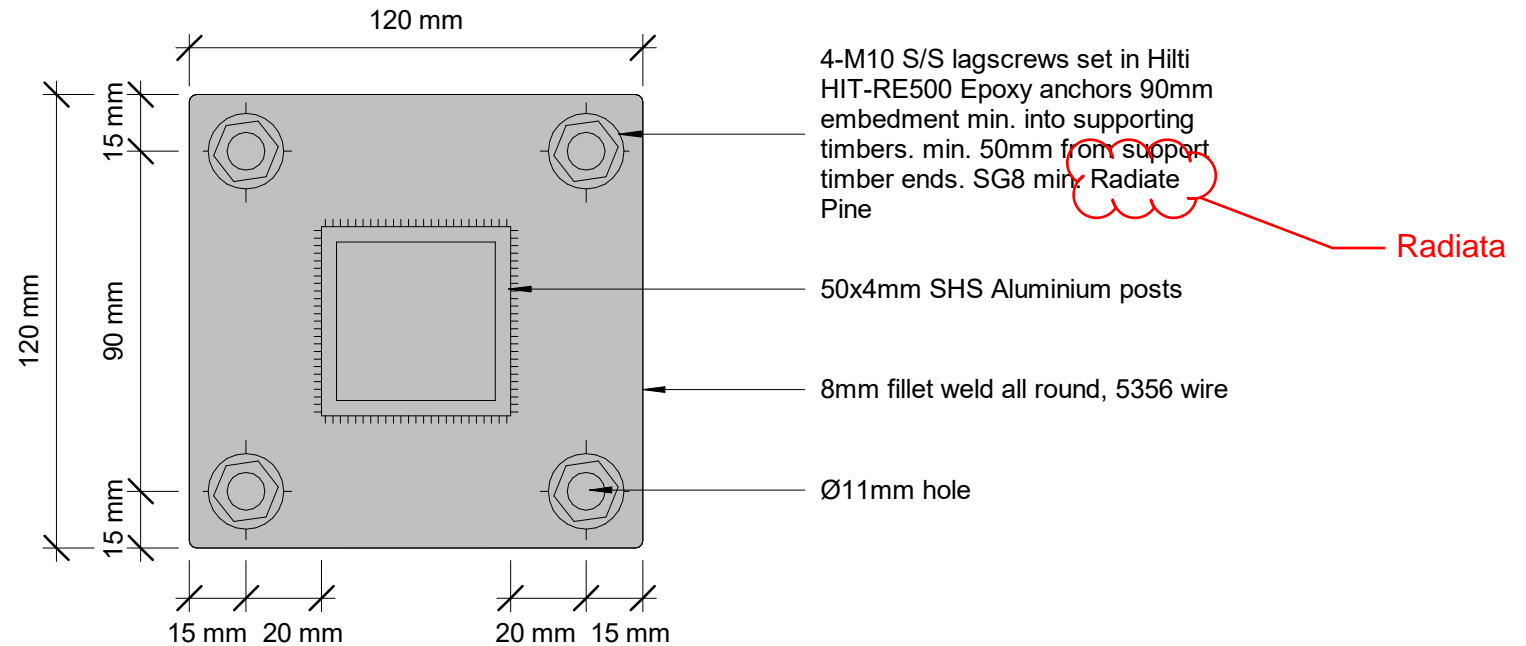

These drawings relate only to the Glass Vice Floating Timber Deck framing and its fixings. All other elements are shown indicative only.

© 2021. The copyright of this document is the property of Glass Vice Limited and shall not be reproduced, copied, loaned or disposed of directly, or indirectly, nor used for any purpose other than that for which it is specifically furnished without prior consent.

gv\_pergola\_ktalt.d.rvt  
All dimensions in millimetres

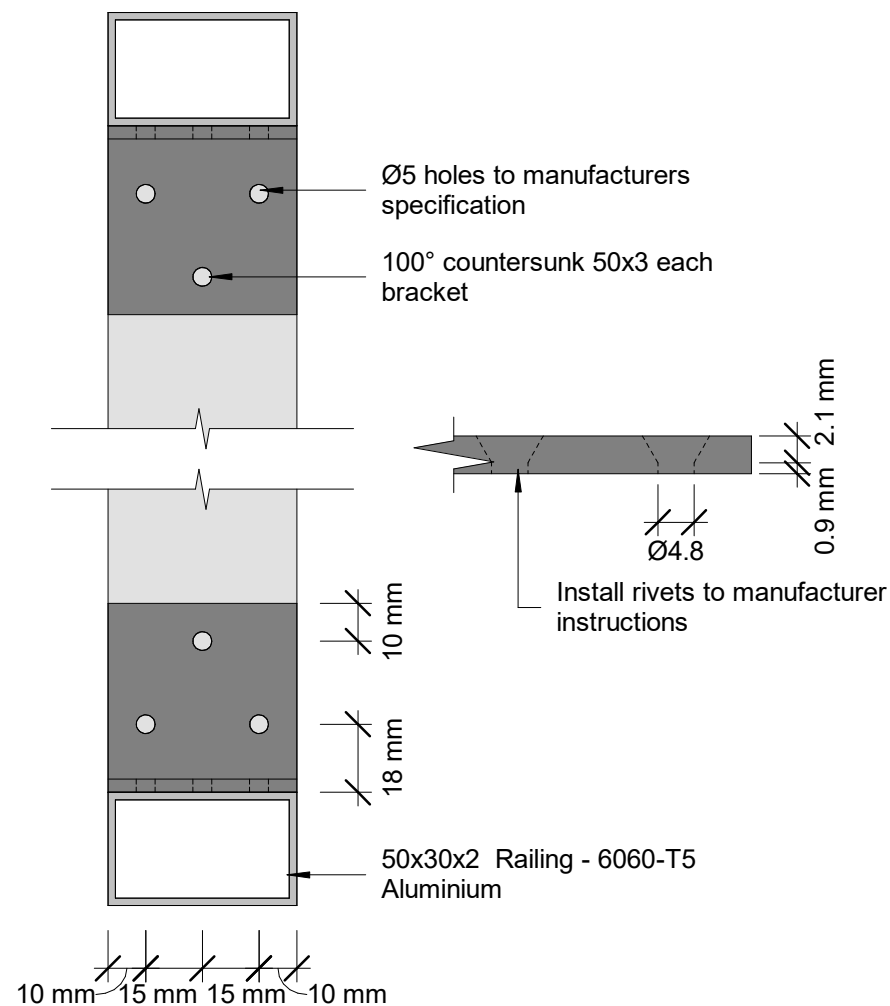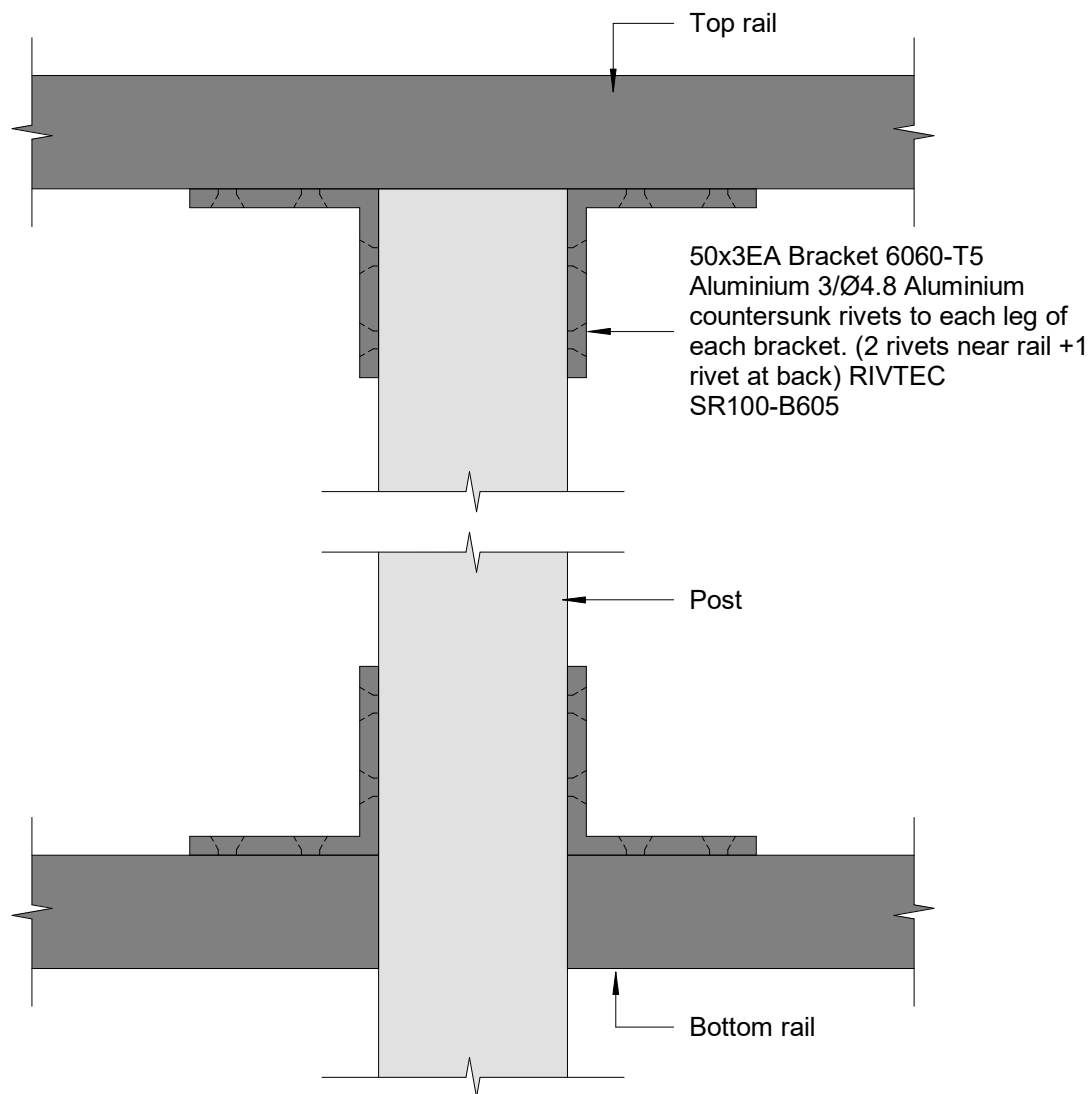

These drawings relate only to the Glass Vice Floating Timber Deck framing and its fixings. All other elements are shown indicative only.

© 2021. The copyright of this document is the property of Glass Vice Limited and shall not be reproduced, copied, loaned or disposed of directly, or indirectly, nor used for any purpose other than that for which it is specifically furnished without prior consent.



# Glass Vice Pergolas and Screens


Pergola  
Connections

Date: Nov 2021  
Scale: As indicated  
Draft E

Quick Code:

gv\_pergola\_ktaldt.rvt  
All dimensions in millimetres  
www.glassvice.com  
Phone +64 9 414 6565  
info@glassvice.com


#GV\_PER\_609

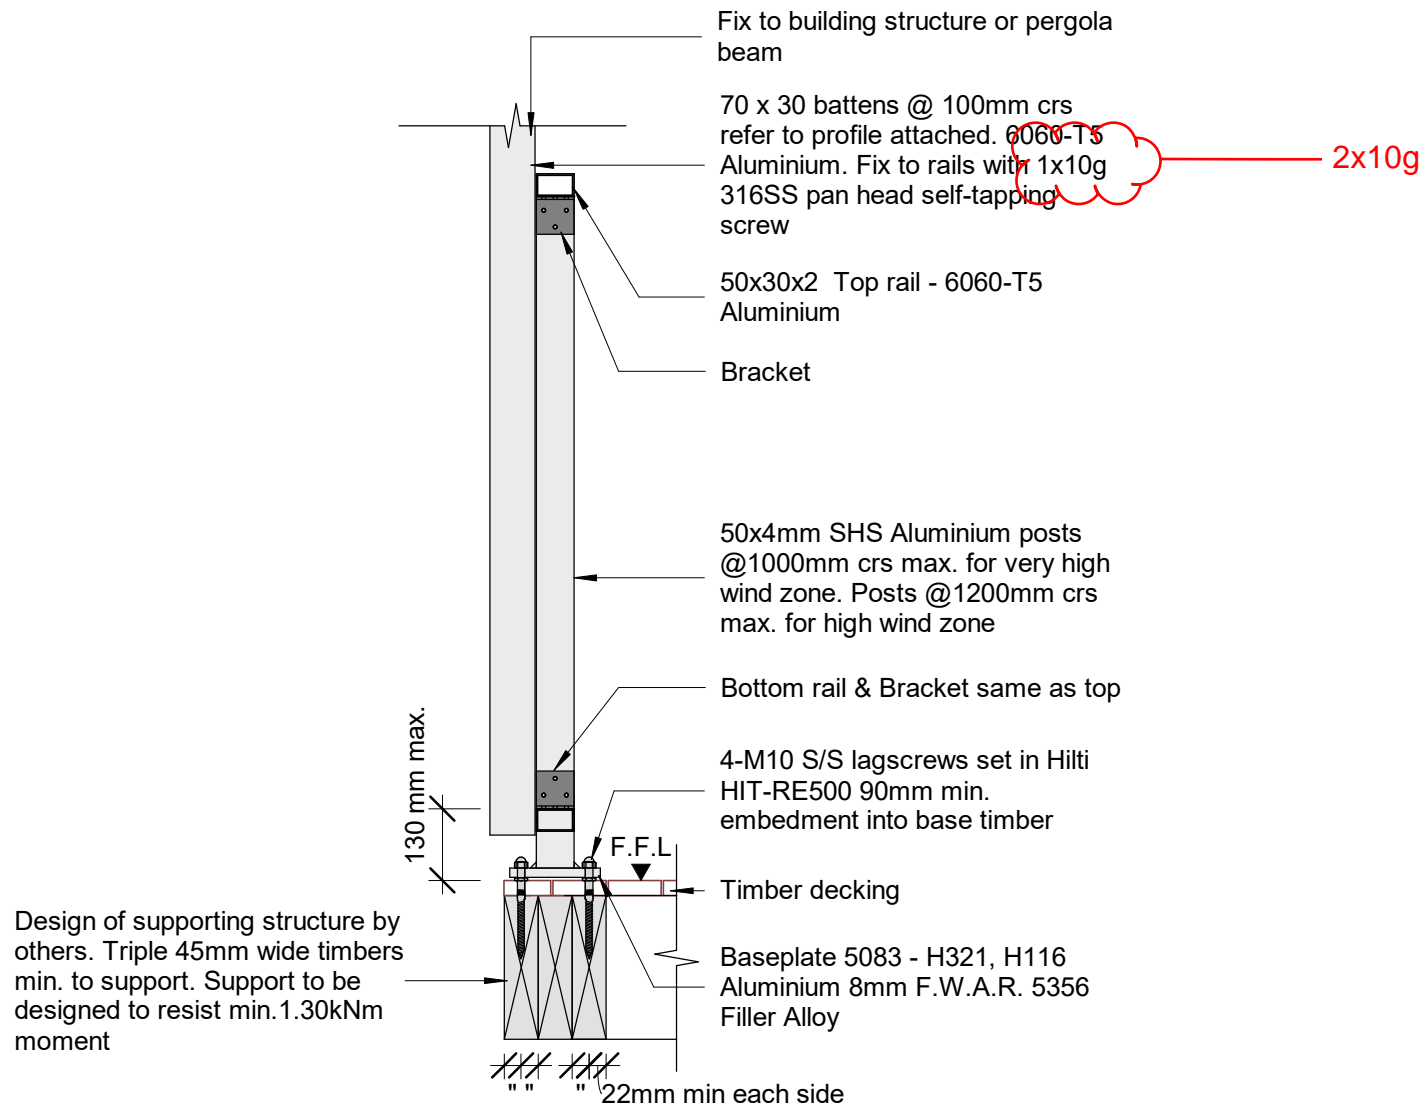

These drawings relate only to the Glass Vice Floating Timber Deck framing and its fixings. All other elements are shown indicative only.

© 2021. The copyright of this document is the property of Glass Vice Limited and shall not be reproduced, copied, loaned or disposed of directly, or indirectly, nor used for any purpose other than that for which it is specifically furnished without prior consent.


gv\_pergola\_ktald.rvt  
All dimensions in millimetres

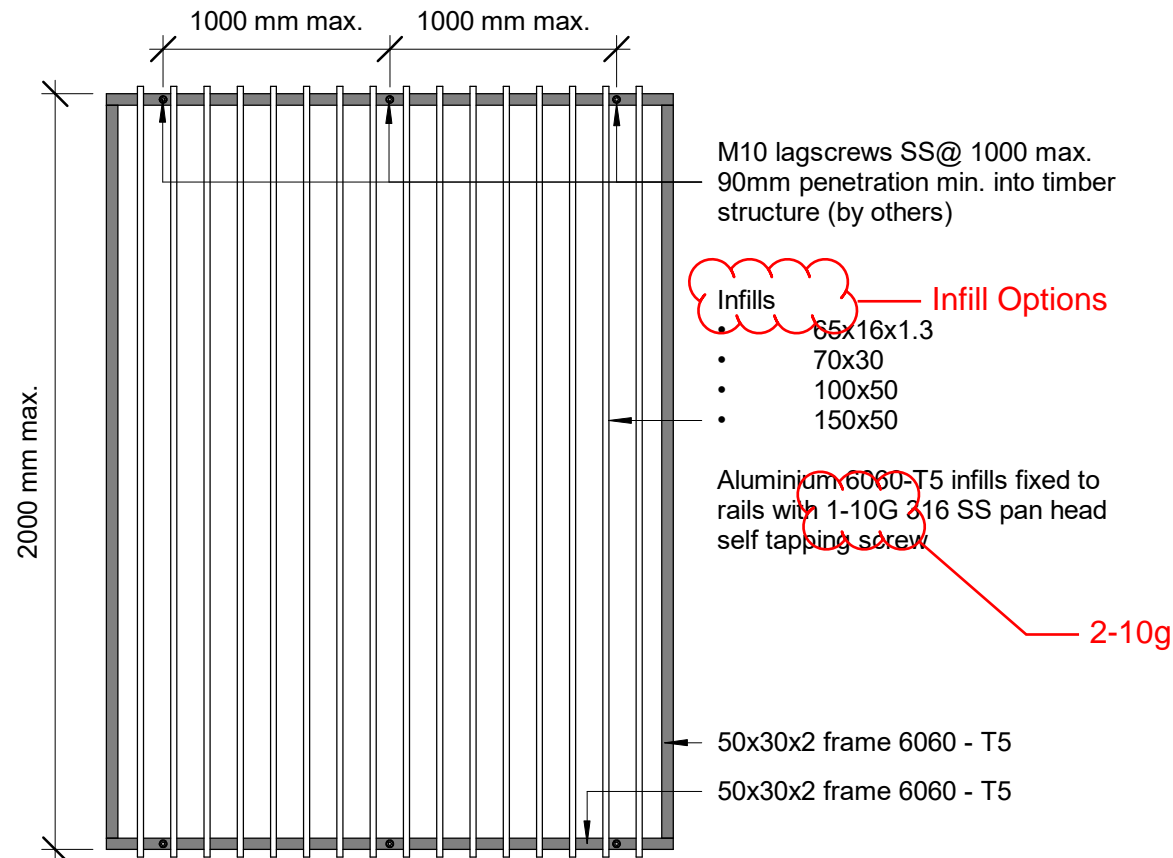

These drawings relate only to the Glass Vice Floating Timber Deck framing and its fixings. All other elements are shown indicative only.

© 2021. The copyright of this document is the property of Glass Vice Limited and shall not be reproduced, copied, loaned or disposed of directly, or indirectly, nor used for any purpose other than that for which it is specifically furnished without prior consent.



gv\_pergola\_ktald.rvt  
All dimensions in millimetres

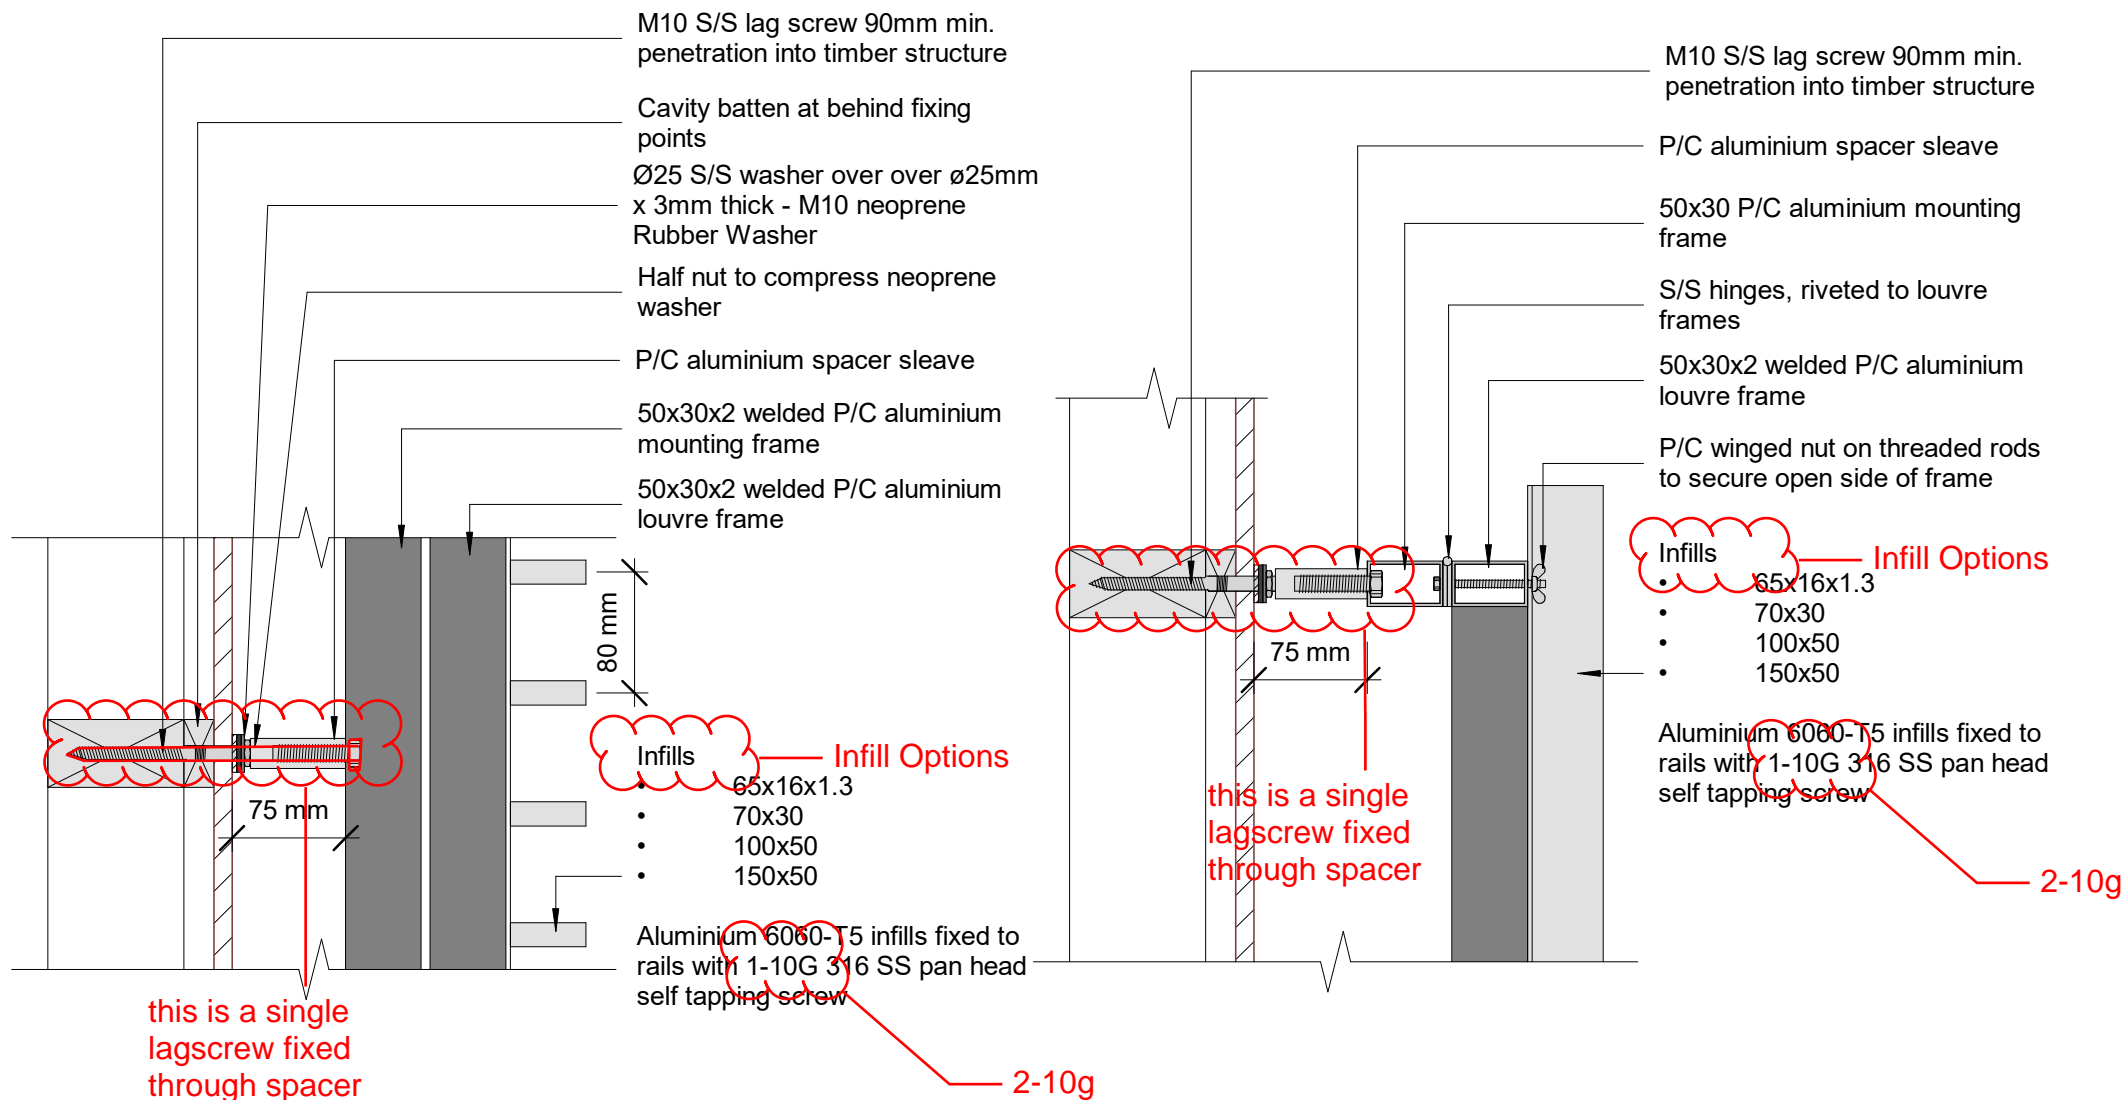

These drawings relate only to the Glass Vice Floating Timber Deck framing and its fixings. All other elements are shown indicative only.

© 2021. The copyright of this document is the property of Glass Vice Limited and shall not be reproduced, copied, loaned or disposed of directly, or indirectly, nor used for any purpose other than that for which it is specifically furnished without prior consent.

gv\_pergola\_ktaldt.rvt  
All dimensions in millimetres

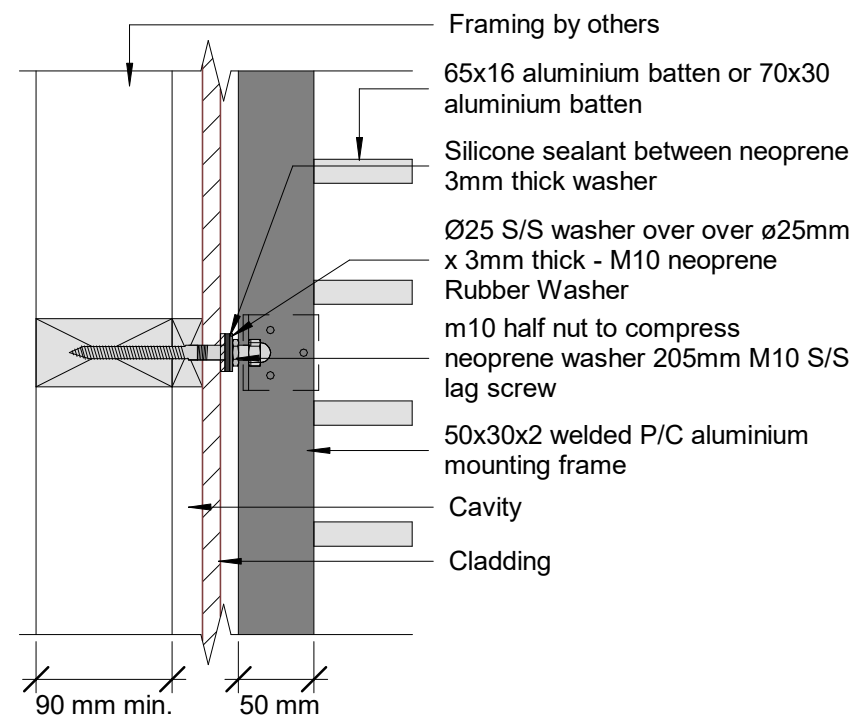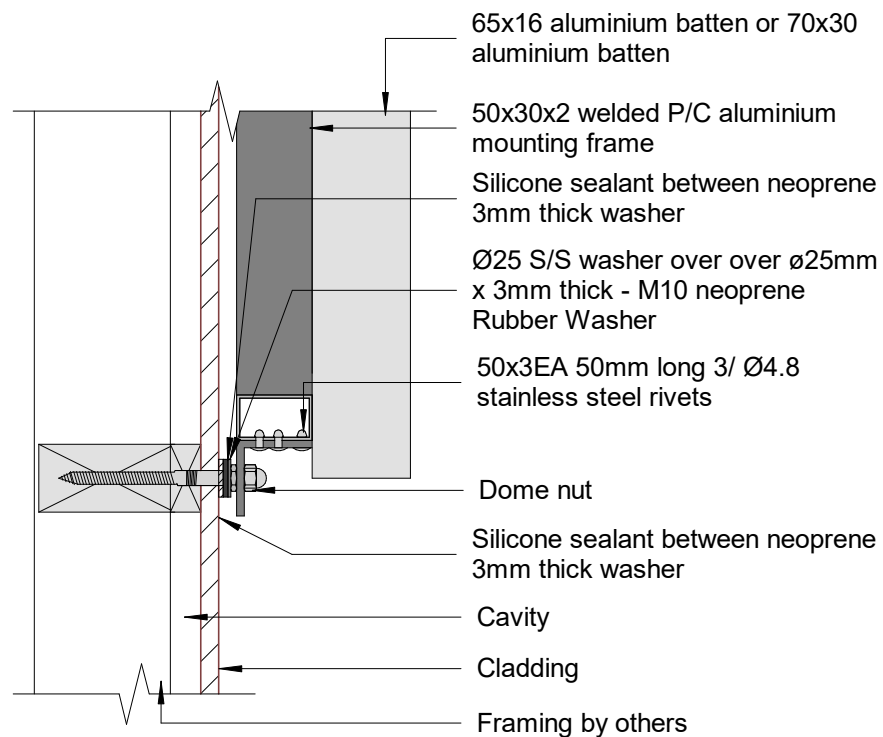

These drawings relate only to the Glass Vice Floating Timber Deck framing and its fixings. All other elements are shown indicative only.

© 2021. The copyright of this document is the property of Glass Vice Limited and shall not be reproduced, copied, loaned or disposed of directly, or indirectly, nor used for any purpose other than that for which it is specifically furnished without prior consent.



# Glass Vice Pergolas and Screens

Pergola

Typical Fixing Detail For Louvre Screens

Date: Nov 2021  
Scale: 1 : 5  
Draft E

Quick Code:

gv\_pergola\_ktald.rvt  
All dimensions in millimetres  
www.glassvice.com  
Phone +64 9 414 6565  
info@glassvice.com

#GV\_SCR\_602b



50x30x2 welded P/C aluminium  
mounting frame


M10 S/S Lag screw 90mm min.  
penetration

45x90 framing timber

Soffit

Ø25 neoprene washer 6mm  
compressed




M10 x 30mm barrel nut

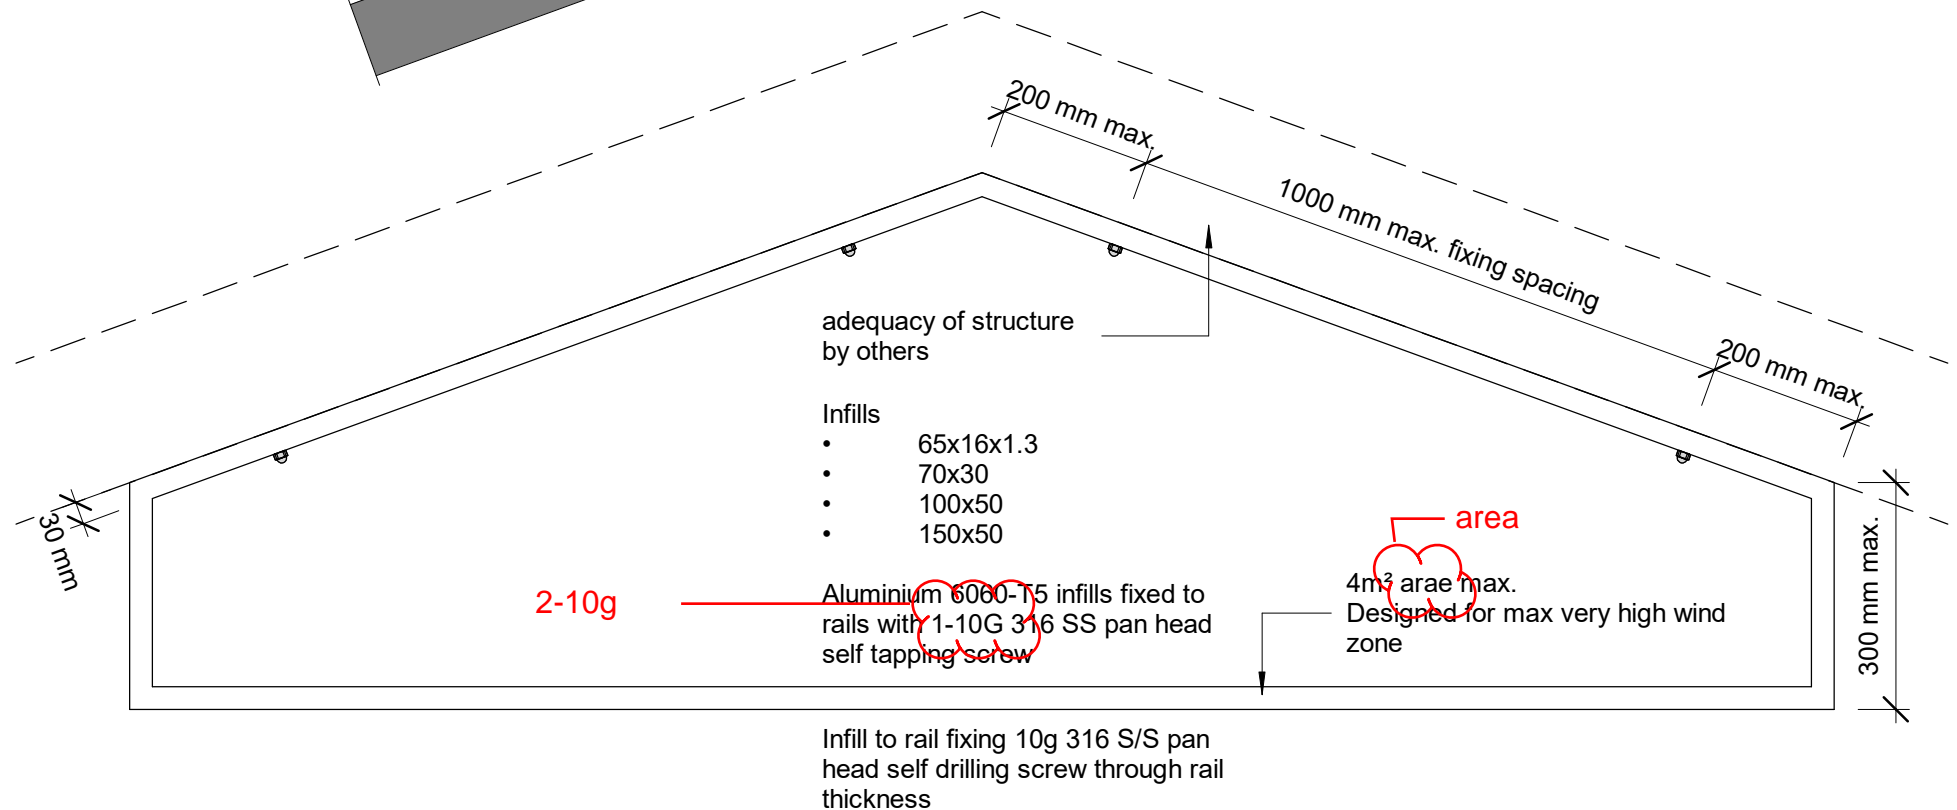

These drawings relate only to the Glass Vice Floating Timber Deck framing and its fixings. All other elements are shown indicative only.

© 2021. The copyright of this document is the property of Glass Vice Limited and shall not be reproduced, copied, loaned or disposed  
of directly, or indirectly, nor used for any purpose other than that for which it is specifically furnished without prior consent.

gv\_pergola\_ktaldt.rvt  
All dimensions in millimetres

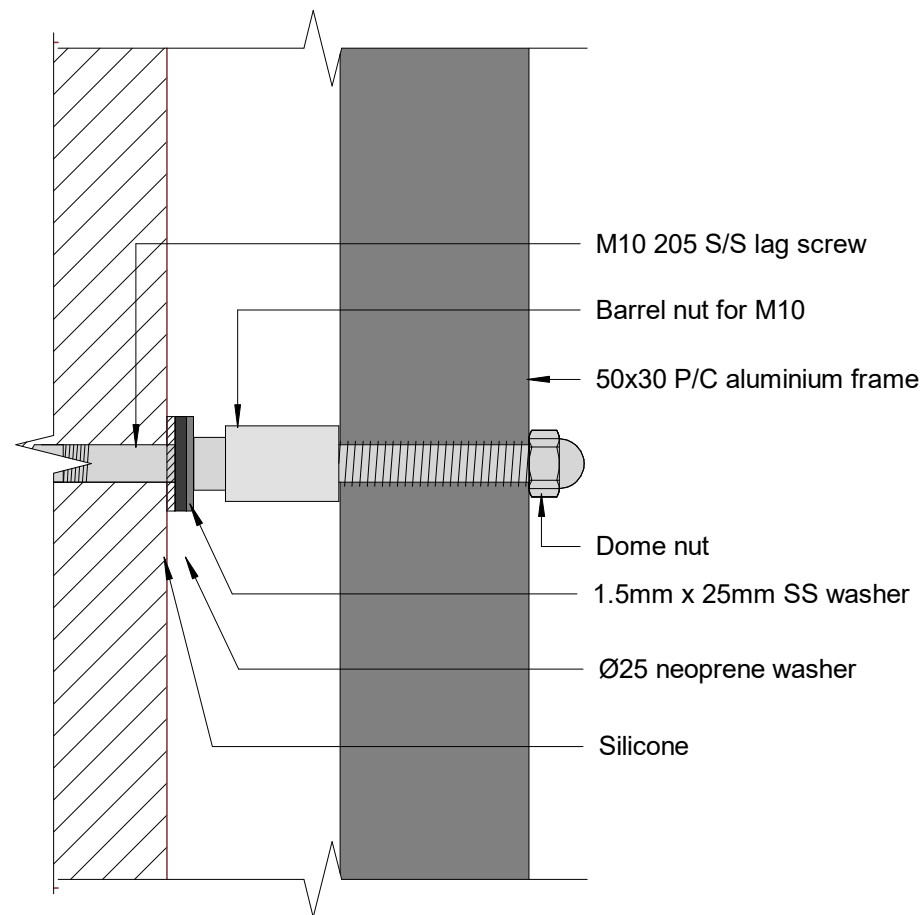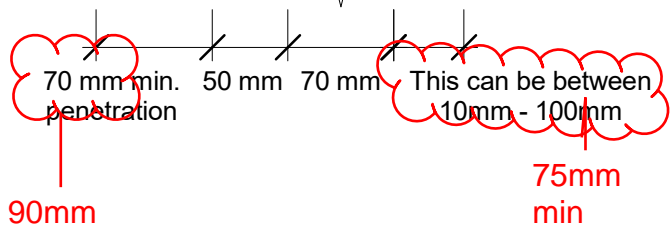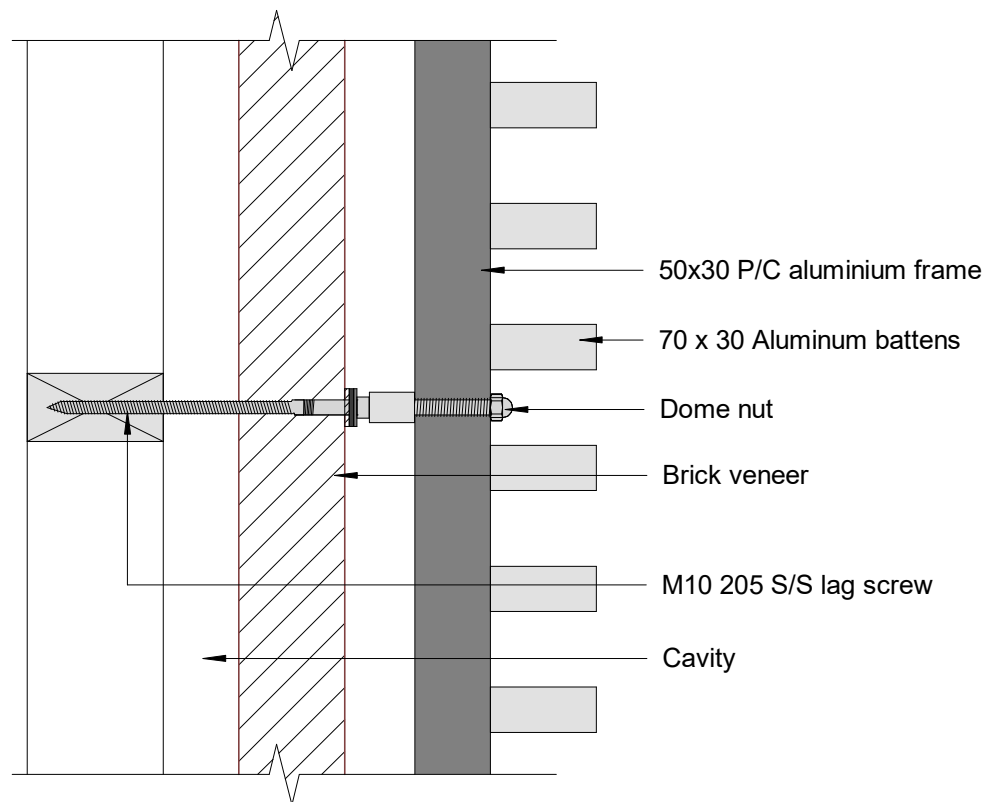

These drawings relate only to the Glass Vice Floating Timber Deck framing and its fixings. All other elements are shown indicative only.

© 2021. The copyright of this document is the property of Glass Vice Limited and shall not be reproduced, copied, loaned or disposed of directly, or indirectly, nor used for any purpose other than that for which it is specifically furnished without prior consent.



# Glass Vice Pergolas and Screens

Pergola


Screen Connection - Brick Veneer

Date: Nov 2021  
Scale: As indicated  
Draft E

Quick Code:

gv\_pergola\_ktaldt.rvt  
All dimensions in millimetres  
www.glassvice.com  
Phone +64 9 414 6565  
info@glassvice.com

#GV\_SCR\_604

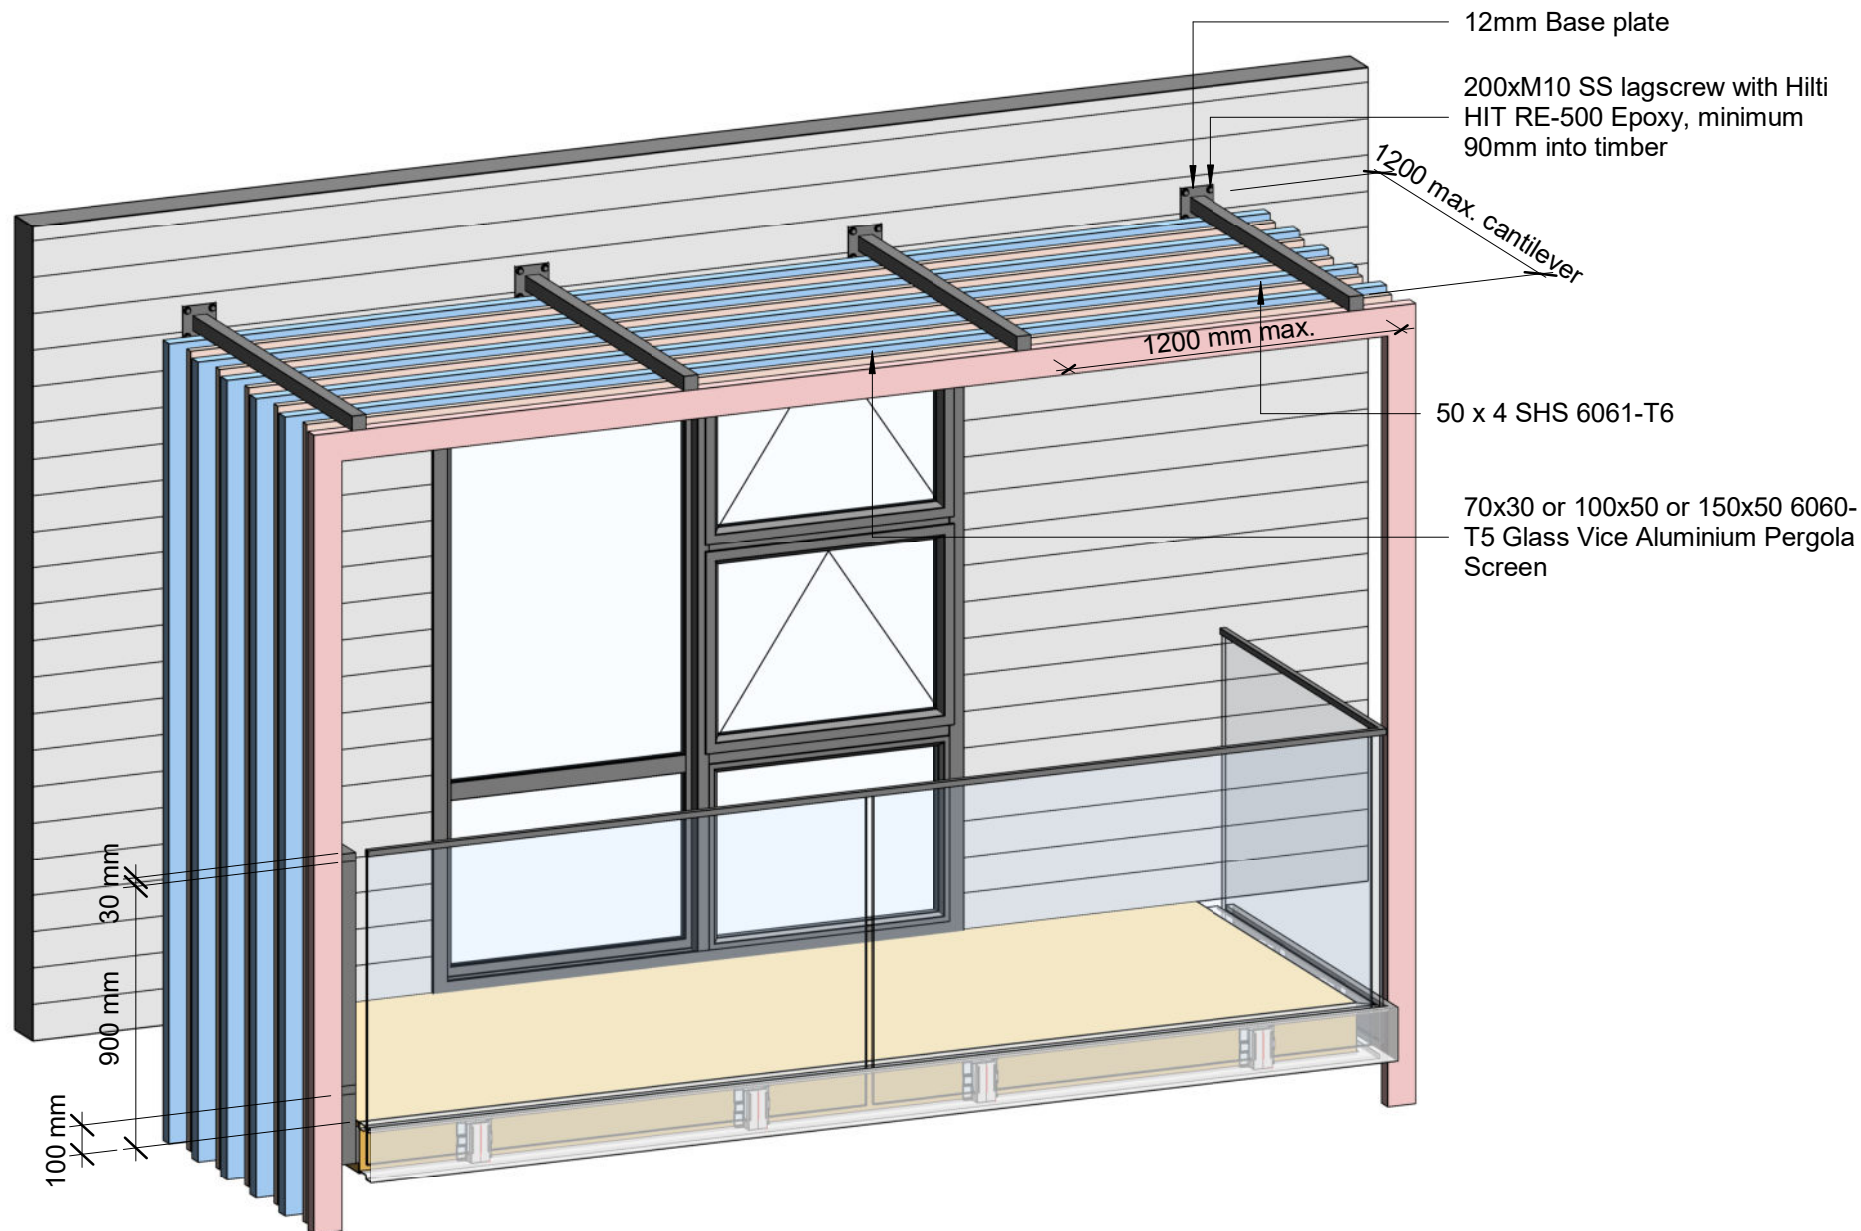

These drawings relate only to the Glass Vice Floating Timber Deck framing and its fixings. All other elements are shown indicative only.

© 2021. The copyright of this document is the property of Glass Vice Limited and shall not be reproduced, copied, loaned or disposed of directly, or indirectly, nor used for any purpose other than that for which it is specifically furnished without prior consent.



# Glass Vice Pergolas and Screens


Pergola  
Pergola

Date: Nov 2021  
Scale:  
Draft E

Quick Code:

gv\_pergola\_ktaldt.rvt  
All dimensions in millimetres  
www.glassvice.com  
Phone +64 9 414 6565  
info@glassvice.com


GV\_PER\_100

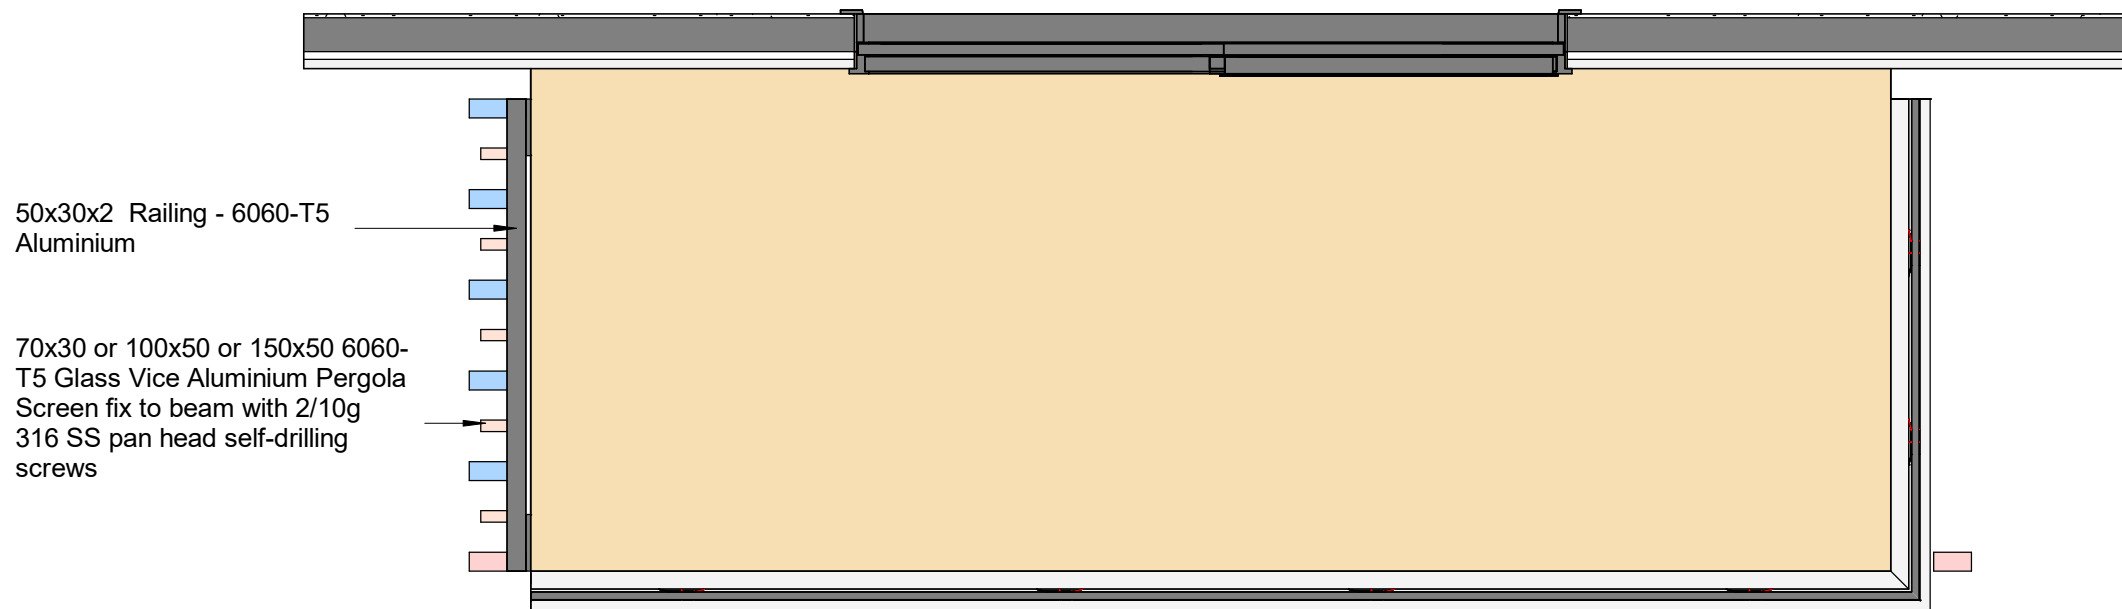

These drawings relate only to the Glass Vice Floating Timber Deck framing and its fixings. All other elements are shown indicative only.

© 2021. The copyright of this document is the property of Glass Vice Limited and shall not be reproduced, copied, loaned or disposed of directly, or indirectly, nor used for any purpose other than that for which it is specifically furnished without prior consent.

gv\_pergola\_ktald.rvt  
All dimensions in millimetres

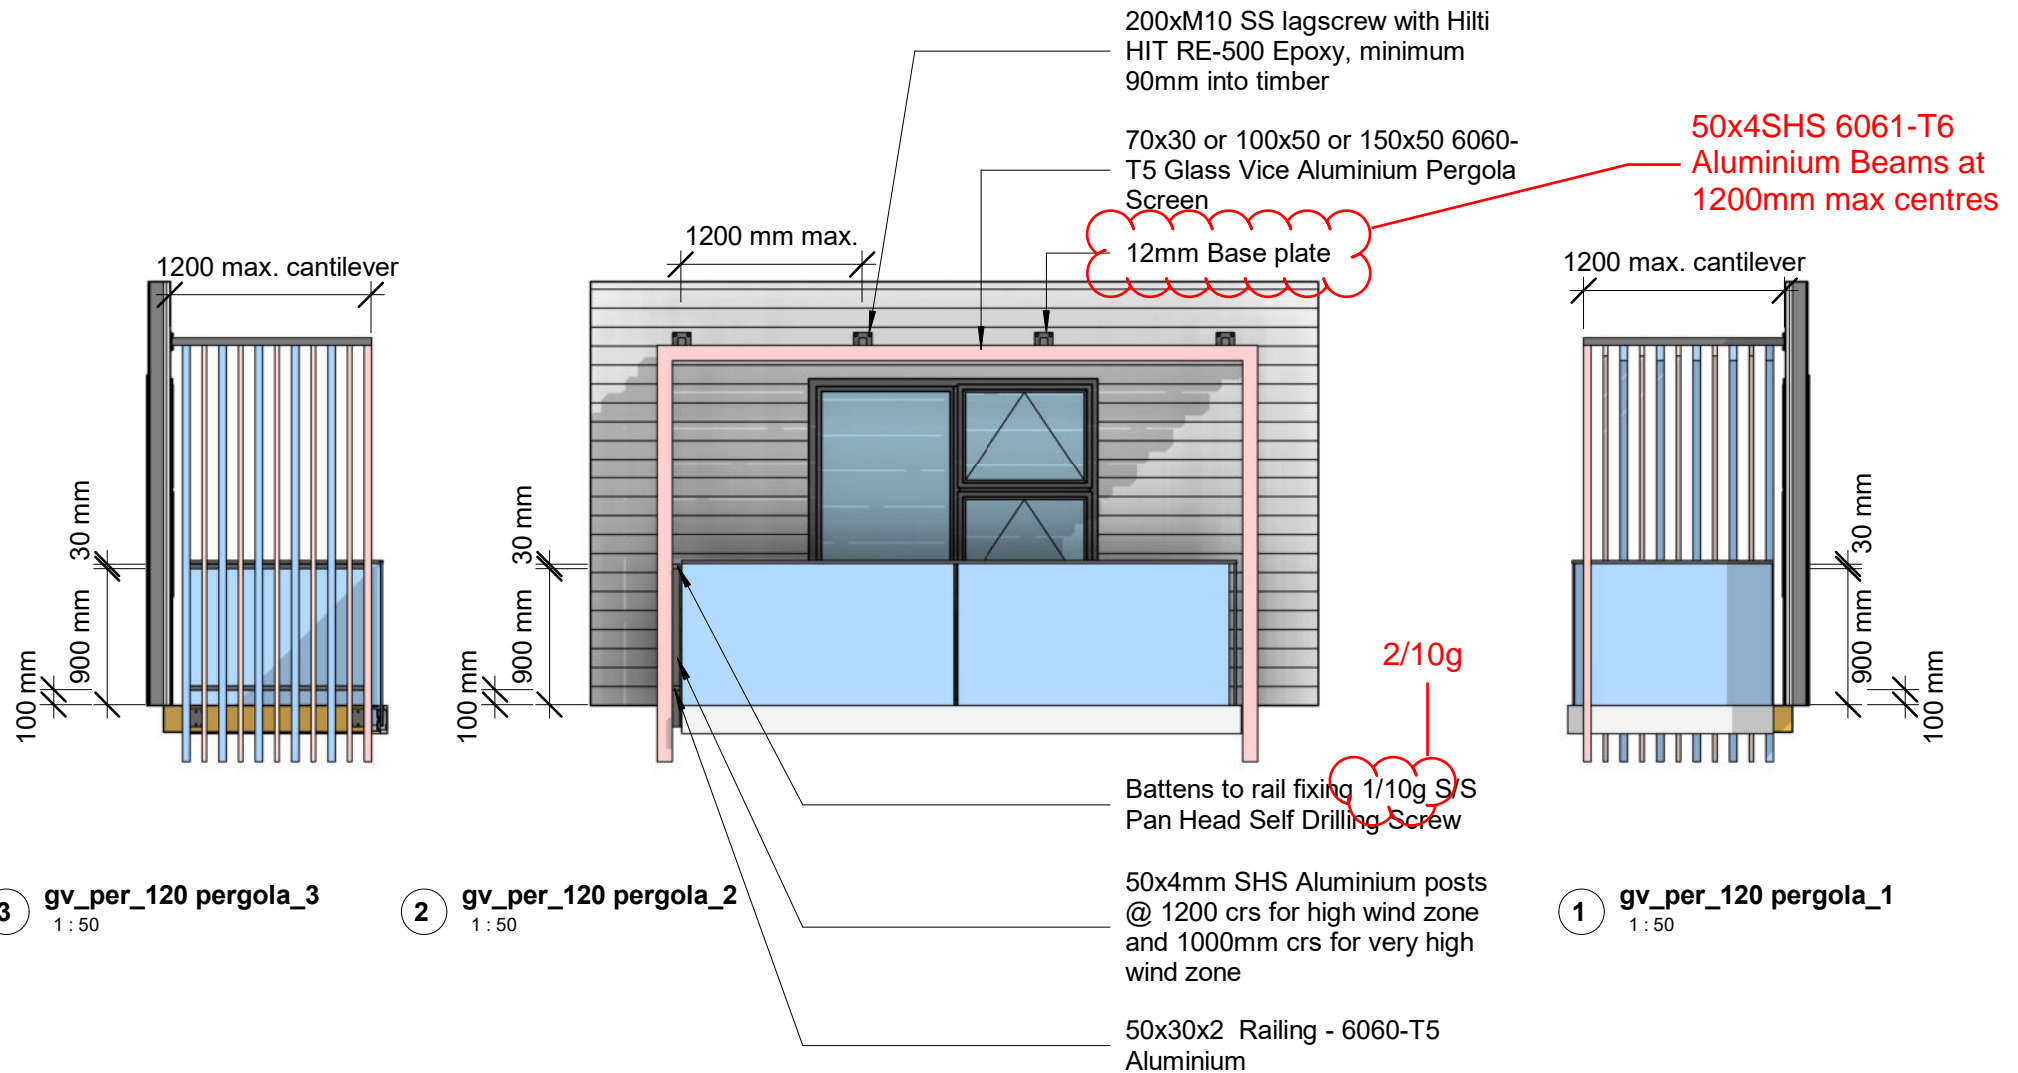

These drawings relate only to the Glass Vice Floating Timber Deck framing and its fixings. All other elements are shown indicative only.

© 2021. The copyright of this document is the property of Glass Vice Limited and shall not be reproduced, copied, loaned or disposed of directly, or indirectly, nor used for any purpose other than that for which it is specifically furnished without prior consent.



# Glass Vice Pergolas and Screens

Pergola  
Pergola


Date: Nov 2021  
Scale: 1 : 50  
Draft E

Quick Code:

gv\_pergola\_ktaldt.rvt  
All dimensions in millimetres

www.glassvice.com  
Phone +64 9 414 6565  
info@glassvice.com

GV\_PER\_120

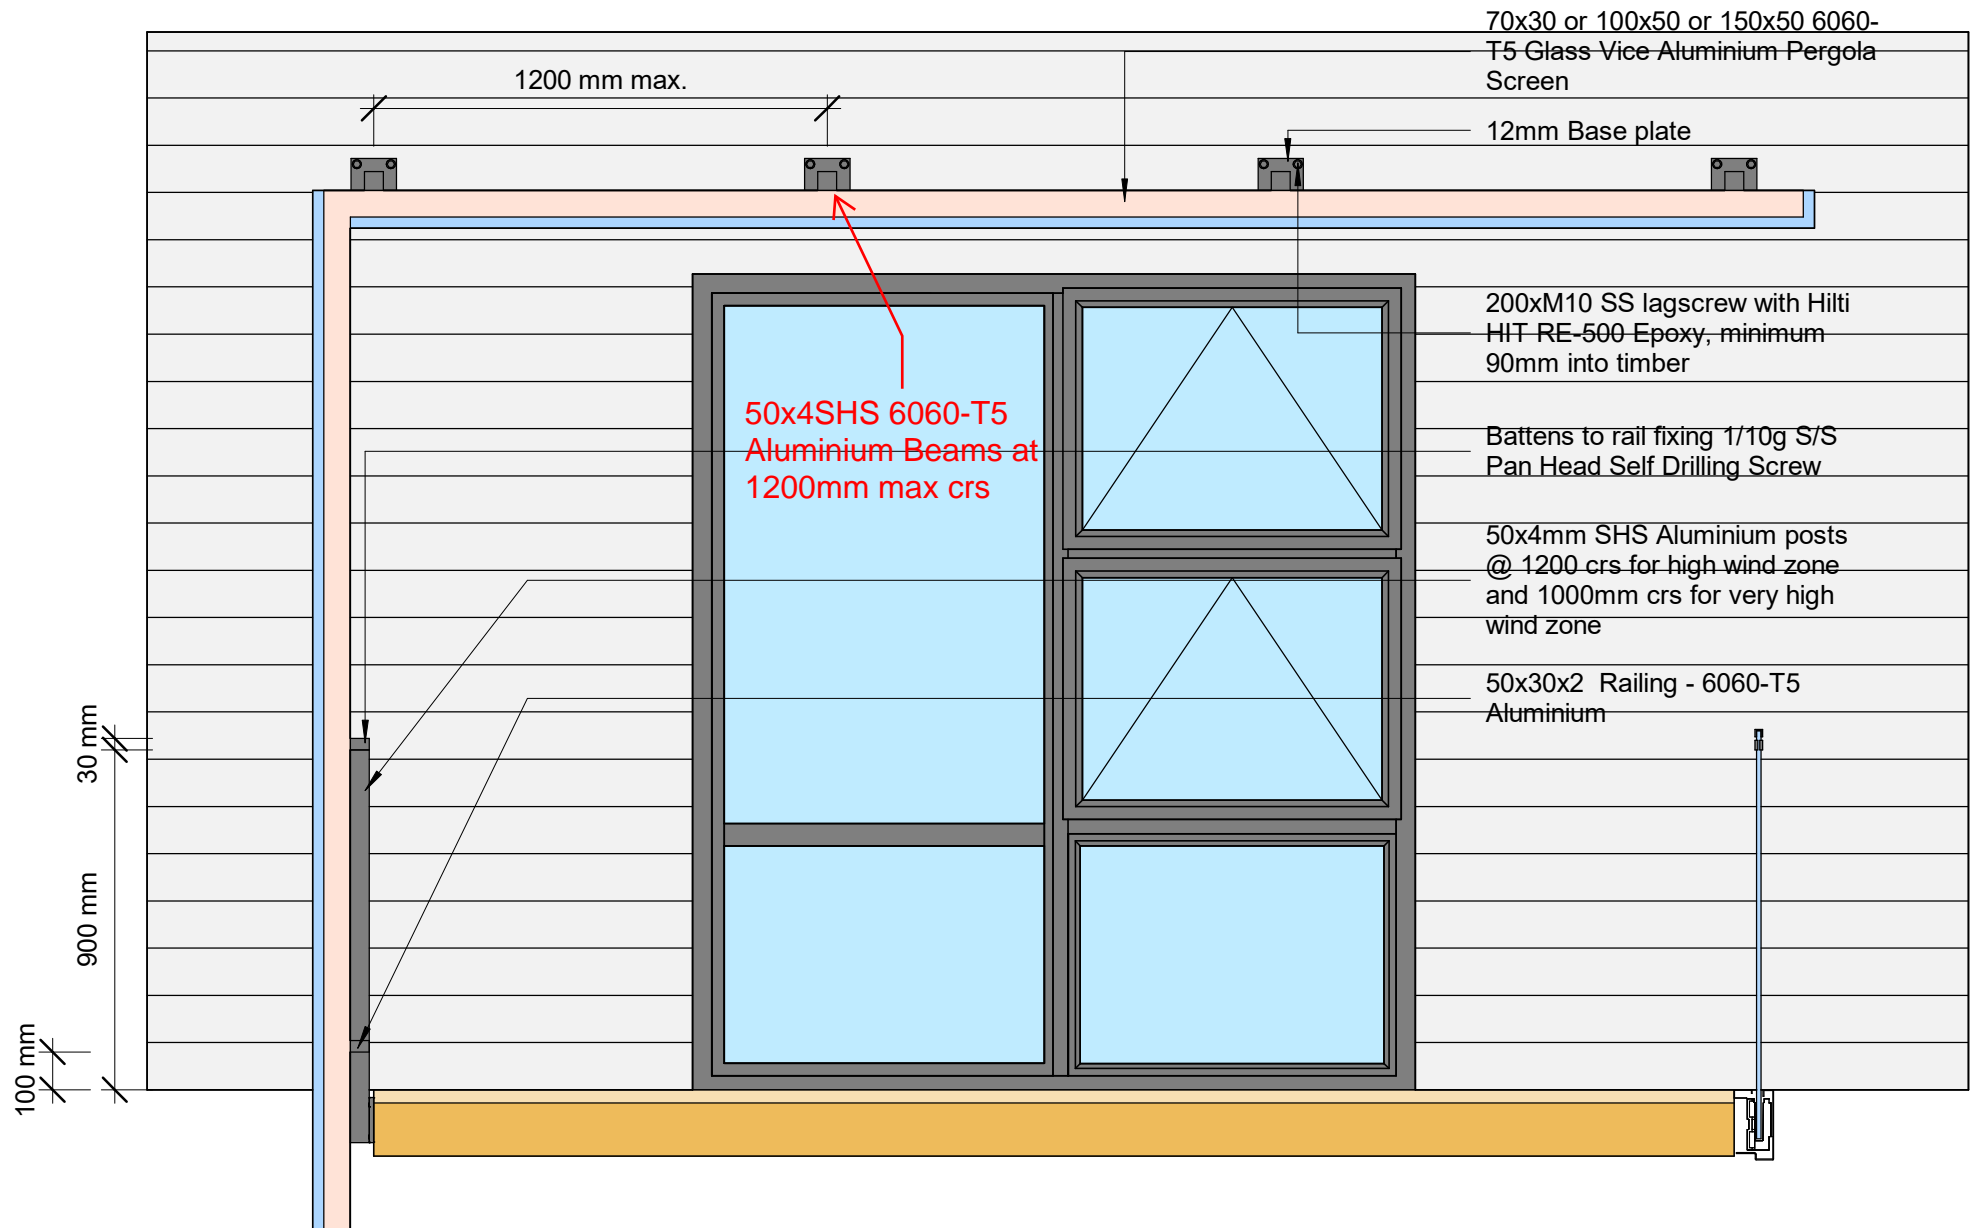

These drawings relate only to the Glass Vice Floating Timber Deck framing and its fixings. All other elements are shown indicative only.

© 2021. The copyright of this document is the property of Glass Vice Limited and shall not be reproduced, copied, loaned or disposed of directly, or indirectly, nor used for any purpose other than that for which it is specifically furnished without prior consent.



# Glass Vice Pergolas and Screens

Pergola  
Pergola Section

Date: Nov 2021  
Scale: 1 : 20  
Draft E

Quick Code:

gv\_pergola\_ktald.rvt  
All dimensions in millimetres

www.glassvice.com  
Phone +64 9 414 6565  
info@glassvice.com

GV\_PER\_130

200xM10 SS lagscrew with Hilti  
HIT RE-500 Epoxy, minimum  
90mm into timber


12mm Base plate

50 x 4 SHS 6061-T6

70x30 or 100x50 or 150x50 6060-  
T5 Glass Vice Aluminium Pergola  
Screen

50x30x2 Railing - 6060-T5  
Aluminium

50x4mm SHS Aluminium posts  
@ 1200 crs for high wind zone  
and 1000mm crs for very high  
wind zone

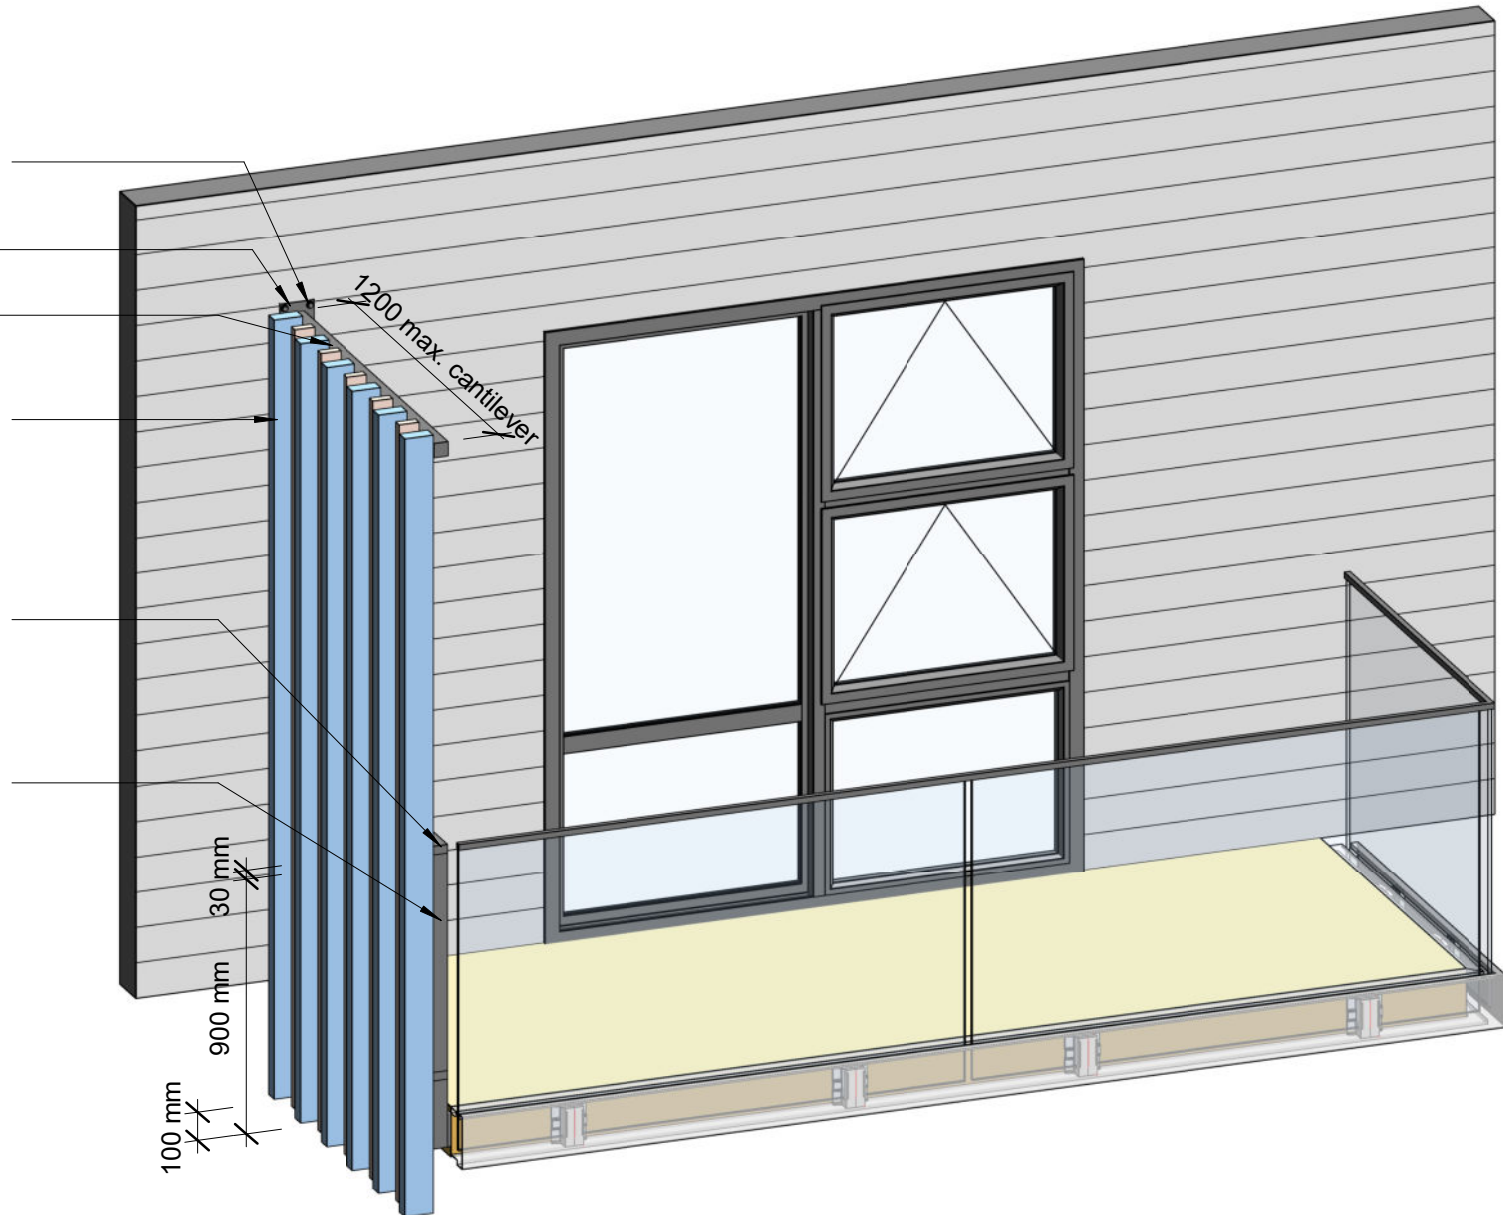

These drawings relate only to the Glass Vice Floating Timber Deck framing and its fixings. All other elements are shown indicative only.

© 2021. The copyright of this document is the property of Glass Vice Limited and shall not be reproduced, copied, loaned or disposed of directly, or indirectly, nor used for any purpose other than that for which it is specifically furnished without prior consent.



## Glass Vice Pergolas and Screens

Pergola  
Vertical Rail

Date: Nov 2021  
Scale:  
Draft E

Quick Code:


gv\_pergola\_ktaldt.rvt  
All dimensions in millimetres

www.glassvice.com  
Phone +64 9 414 6565  
info@glassvice.com

GV\_PER\_200

50x30x2 Railing - 6060-T5  
Aluminium

70x30 or 100x50 or 150x50 6060-  
T5 Glass Vice Aluminium Pergola  
Screen fix to beam with 2/10g 316  
SS pan head self-drilling screws

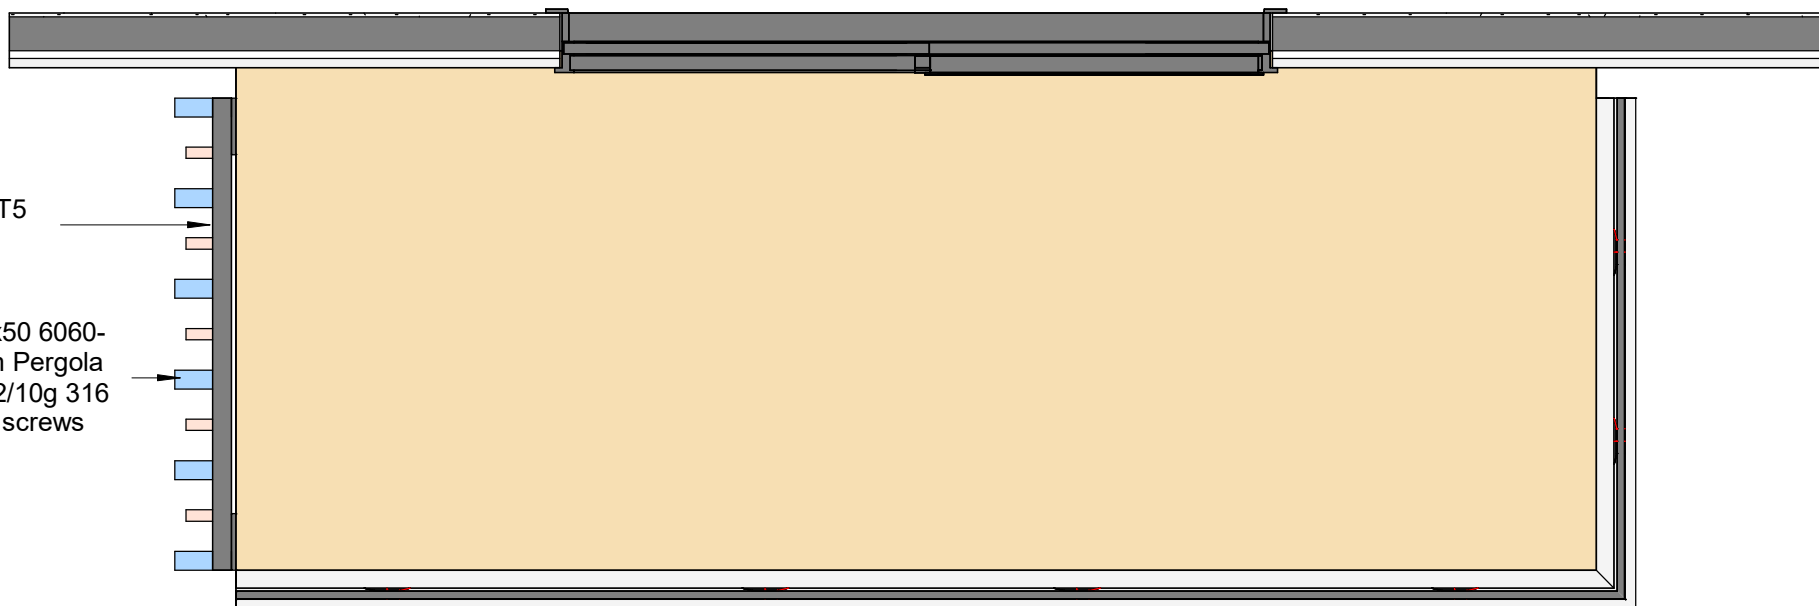

These drawings relate only to the Glass Vice Floating Timber Deck framing and its fixings. All other elements are shown indicative only.

© 2021. The copyright of this document is the property of Glass Vice Limited and shall not be reproduced, copied, loaned or disposed of directly, or indirectly, nor used for any purpose other than that for which it is specifically furnished without prior consent.



## Glass Vice Pergolas and Screens

Pergola

Vertical Rail Plan


Date: Nov 2021  
Scale: 1 : 20  
Draft E

Quick Code:

gv\_pergola\_ktalt.d.rvt  
All dimensions in millimetres  
www.glassvice.com  
Phone +64 9 414 6565  
info@glassvice.com


GV\_PER\_210



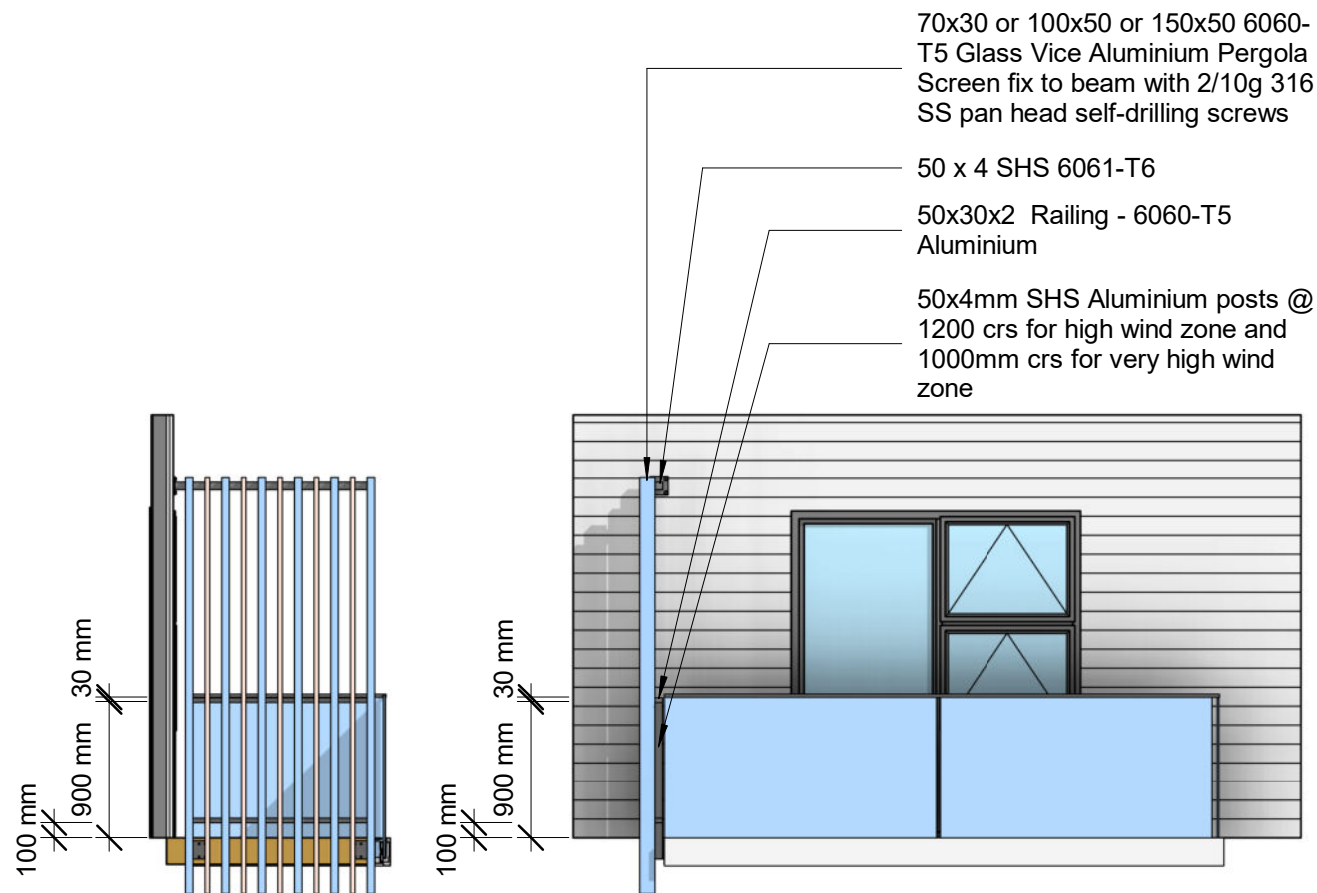

① gv\_per\_220 vertical rail - elevations\_1  
1 : 50

② gv\_per\_220 vertical rail - elevations\_2  
1 : 50

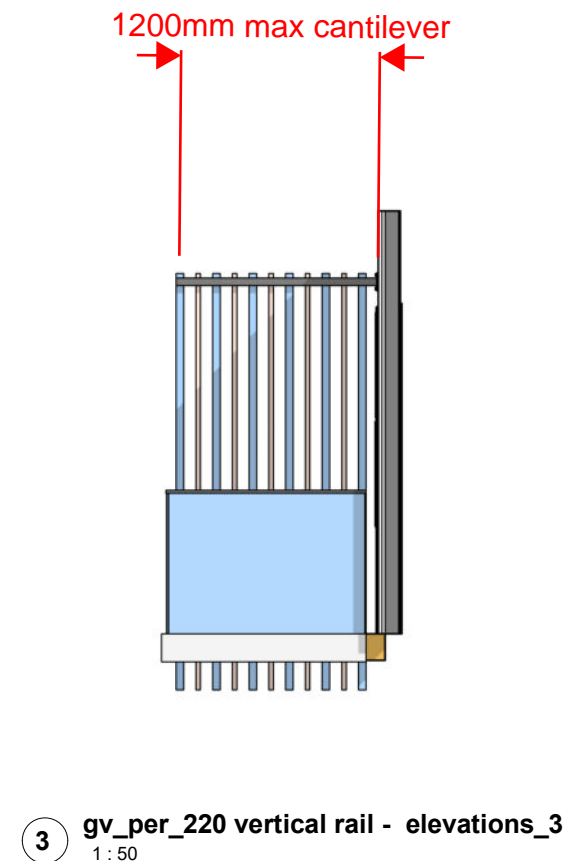

These drawings relate only to the Glass Vice Floating Timber Deck framing and its fixings. All other elements are shown indicative only.

© 2021. The copyright of this document is the property of Glass Vice Limited and shall not be reproduced, copied, loaned or disposed of directly, or indirectly, nor used for any purpose other than that for which it is specifically furnished without prior consent.



# Glass Vice Pergolas and Screens

Pergola

Vertical Rail - Elevations

Date: Nov 2021  
Scale: 1 : 50  
Draft E

Quick Code:

gv\_pergola\_ktaldt.rvt  
All dimensions in millimetres  
www.glassvice.com  
Phone +64 9 414 6565  
info@glassvice.com

GV\_PER\_220




200xM10 SS lagscrew with Hilti  
HIT RE-500 Epoxy, minimum  
90mm into timber

12mm Base plate

50 x 4 SHS 6061-T6

70x30 or 100x50 or 150x50 6060-  
T5 Glass Vice Aluminium Pergola  
Screen

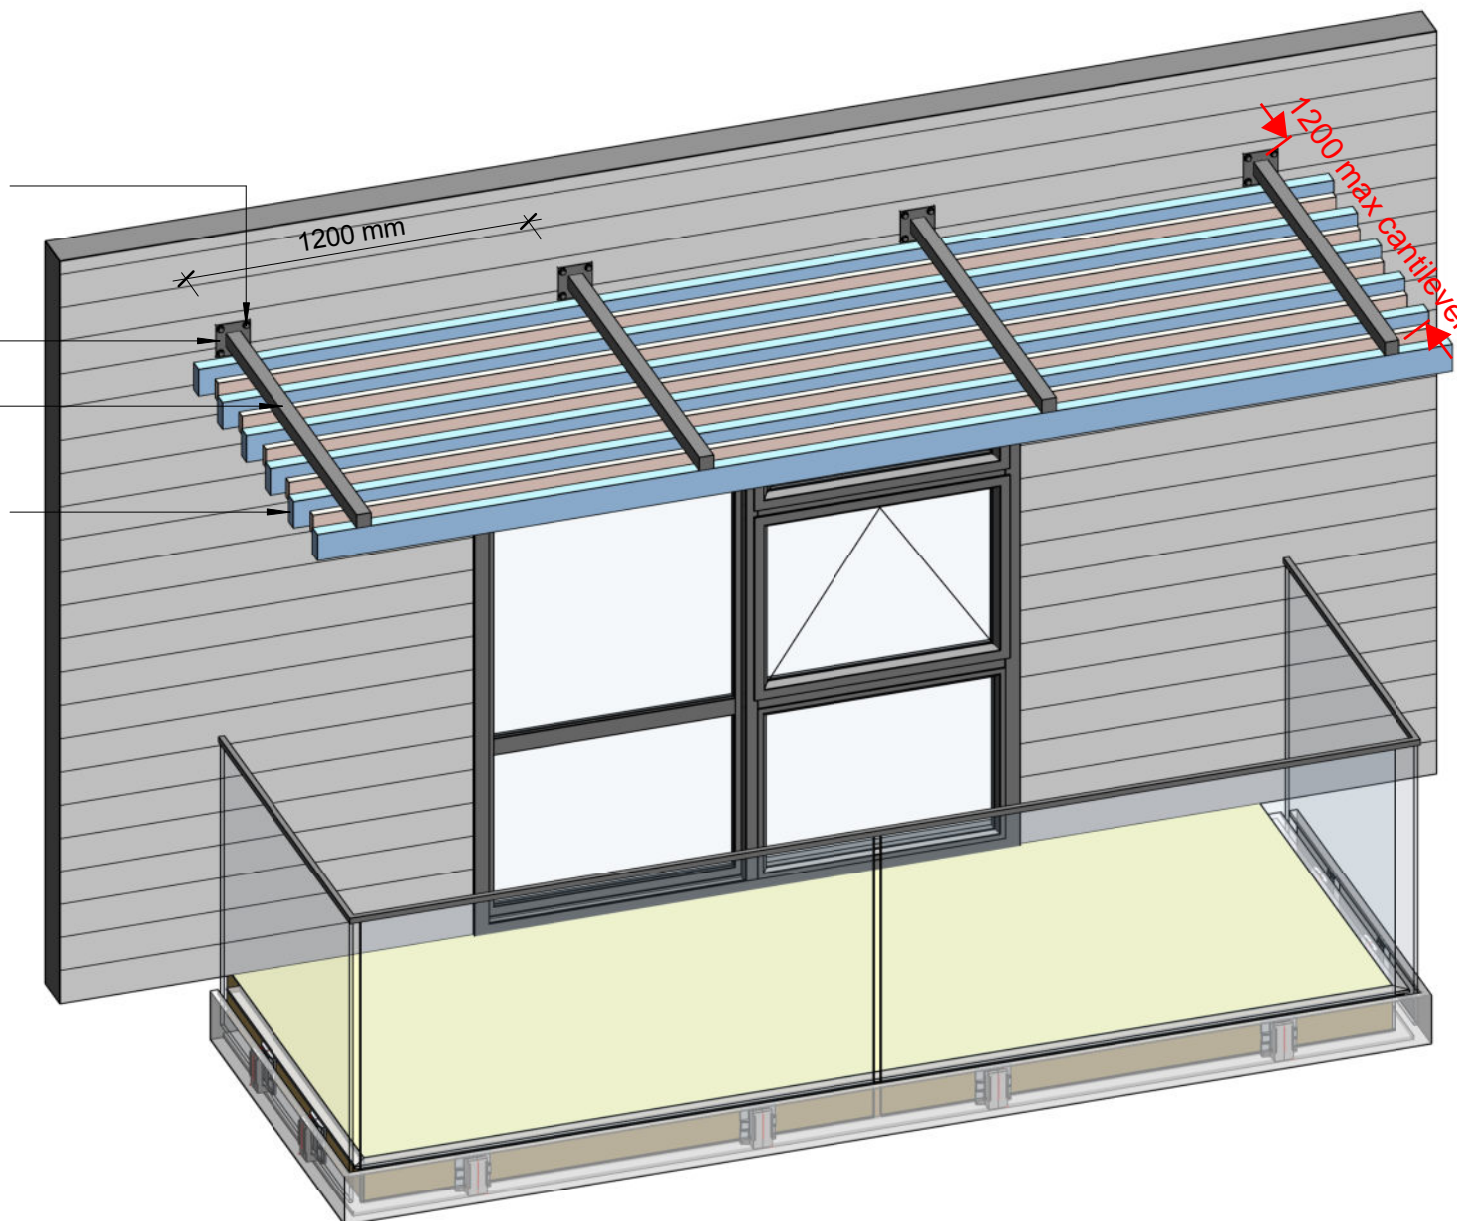

These drawings relate only to the Glass Vice Floating Timber Deck framing and its fixings. All other elements are shown indicative only.

© 2021. The copyright of this document is the property of Glass Vice Limited and shall not be reproduced, copied, loaned or disposed of directly, or indirectly, nor used for any purpose other than that for which it is specifically furnished without prior consent.



## Glass Vice Pergolas and Screens

Pergola  
Ceiling Rails


Date: Nov 2021  
Scale:  
Draft E

Quick Code:

gv\_pergola\_ktaldt.rvt  
All dimensions in millimetres  
www.glassvice.com  
Phone +64 9 414 6565  
info@glassvice.com

GV\_PER\_300

70x30 or 100x50 or 150x50 6060-T5 Glass Vice Aluminium Pergola Screen

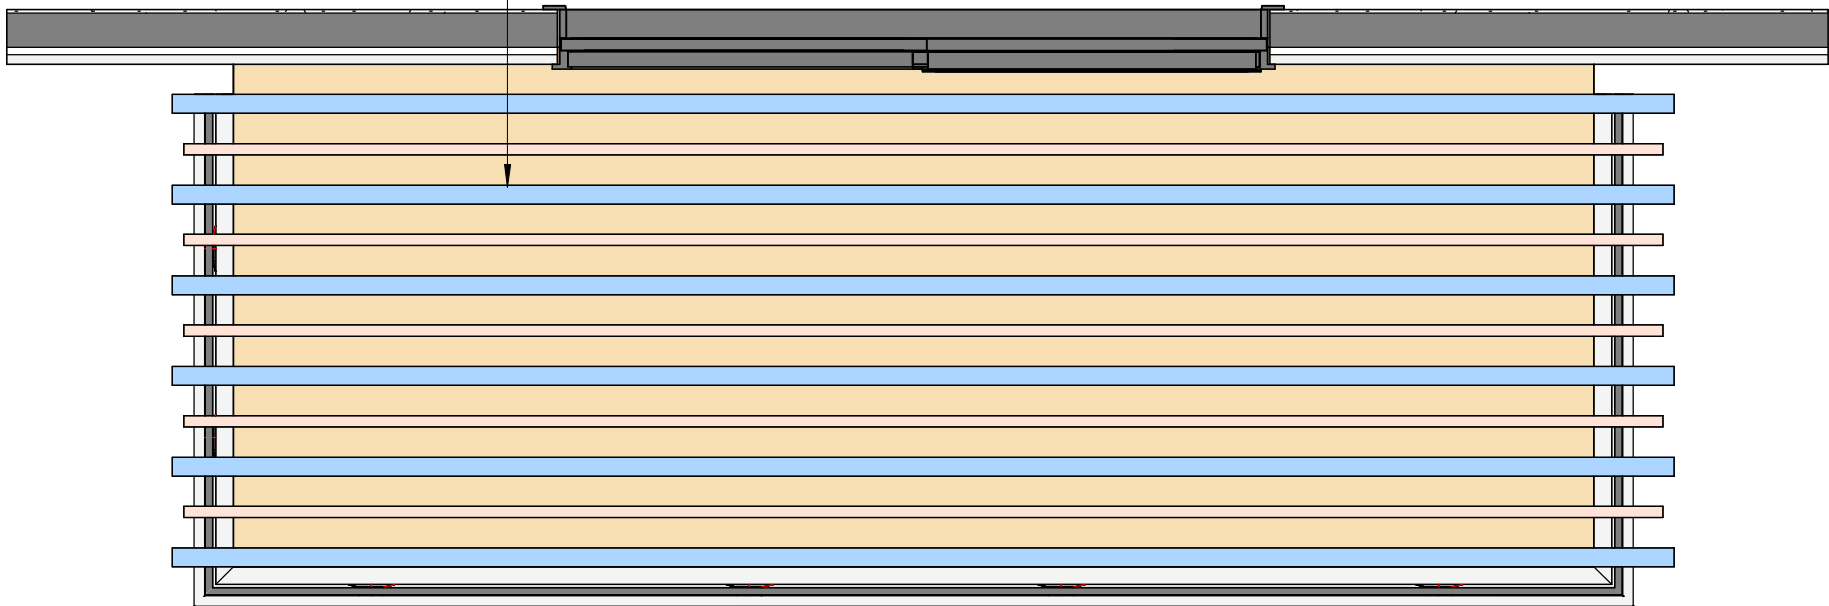

These drawings relate only to the Glass Vice Floating Timber Deck framing and its fixings. All other elements are shown indicative only.

© 2021. The copyright of this document is the property of Glass Vice Limited and shall not be reproduced, copied, loaned or disposed of directly, or indirectly, nor used for any purpose other than that for which it is specifically furnished without prior consent.

gv\_pergola\_ktalt.d.rvt  
All dimensions in millimetres



# Glass Vice Pergolas and Screens

## Pergola


### Ceiling Rails - Plan

Date: Nov 2021  
Scale: 1 : 20  
Draft E

Quick Code:

www.glassvice.com  
Phone +64 9 414 6565  
info@glassvice.com

**GV\_PER\_310**

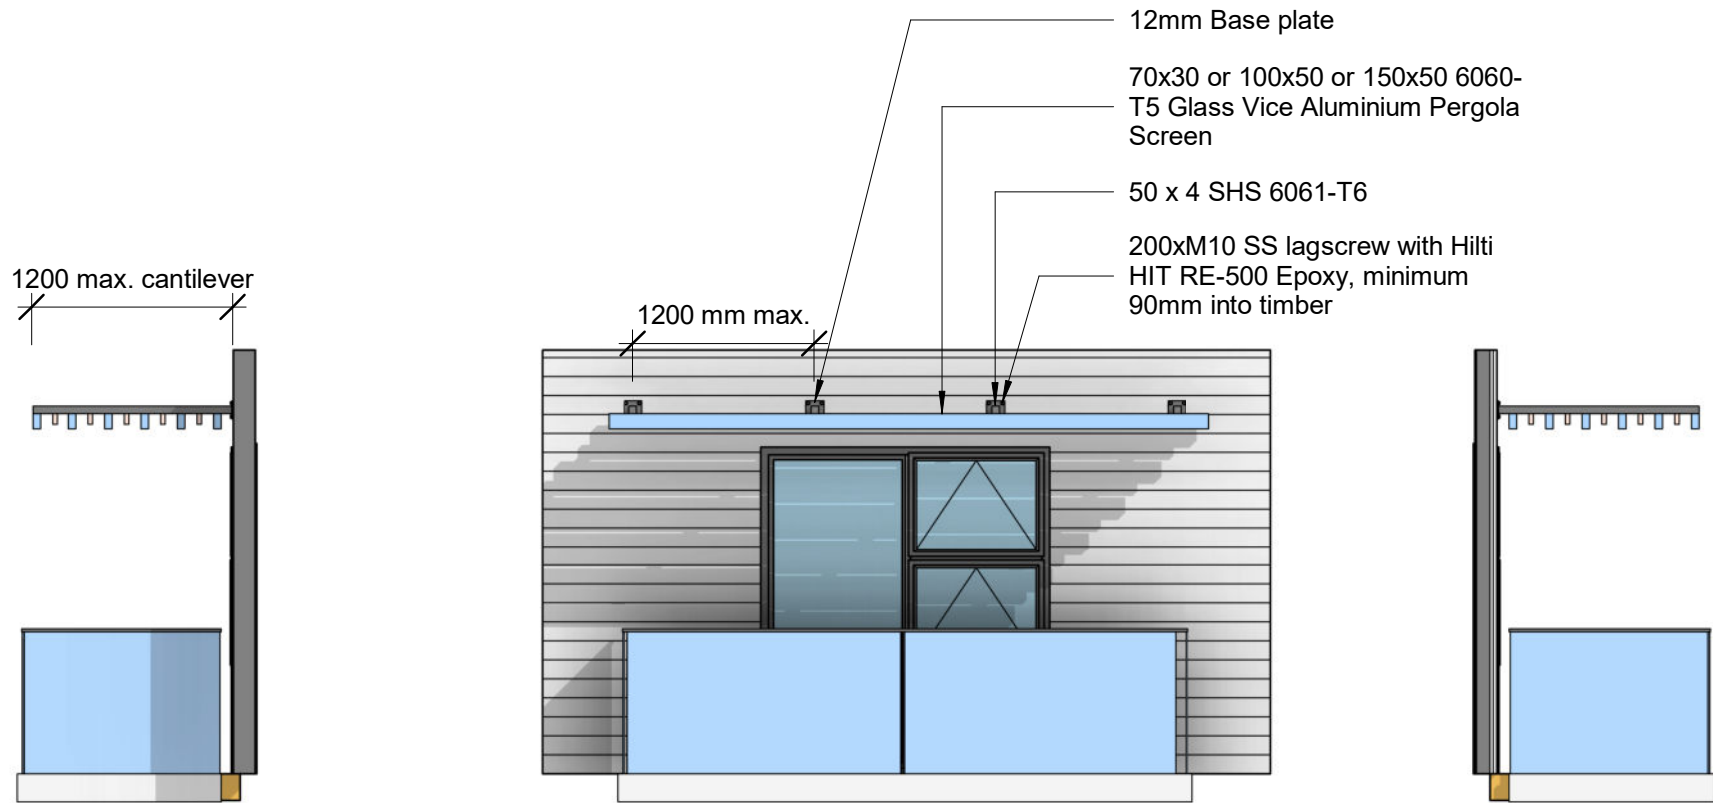

① **gv\_per\_320 ceiling rails\_1**  
1 : 50

② **gv\_per\_320 ceiling rails\_2**  
1 : 50

③ **gv\_per\_320 ceiling rails\_3**  
1 : 50

These drawings relate only to the Glass Vice Floating Timber Deck framing and its fixings. All other elements are shown indicative only.

© 2021. The copyright of this document is the property of Glass Vice Limited and shall not be reproduced, copied, loaned or disposed of directly, or indirectly, nor used for any purpose other than that for which it is specifically furnished without prior consent.



# Glass Vice Pergolas and Screens

## Pergola


### Ceiling Rails

Date: Nov 2021  
Scale: 1 : 50  
Draft E

Quick Code:

gv\_pergola\_ktaldt.rvt  
All dimensions in millimetres  
www.glassvice.com  
Phone +64 9 414 6565  
info@glassvice.com

**GV\_PER\_320**

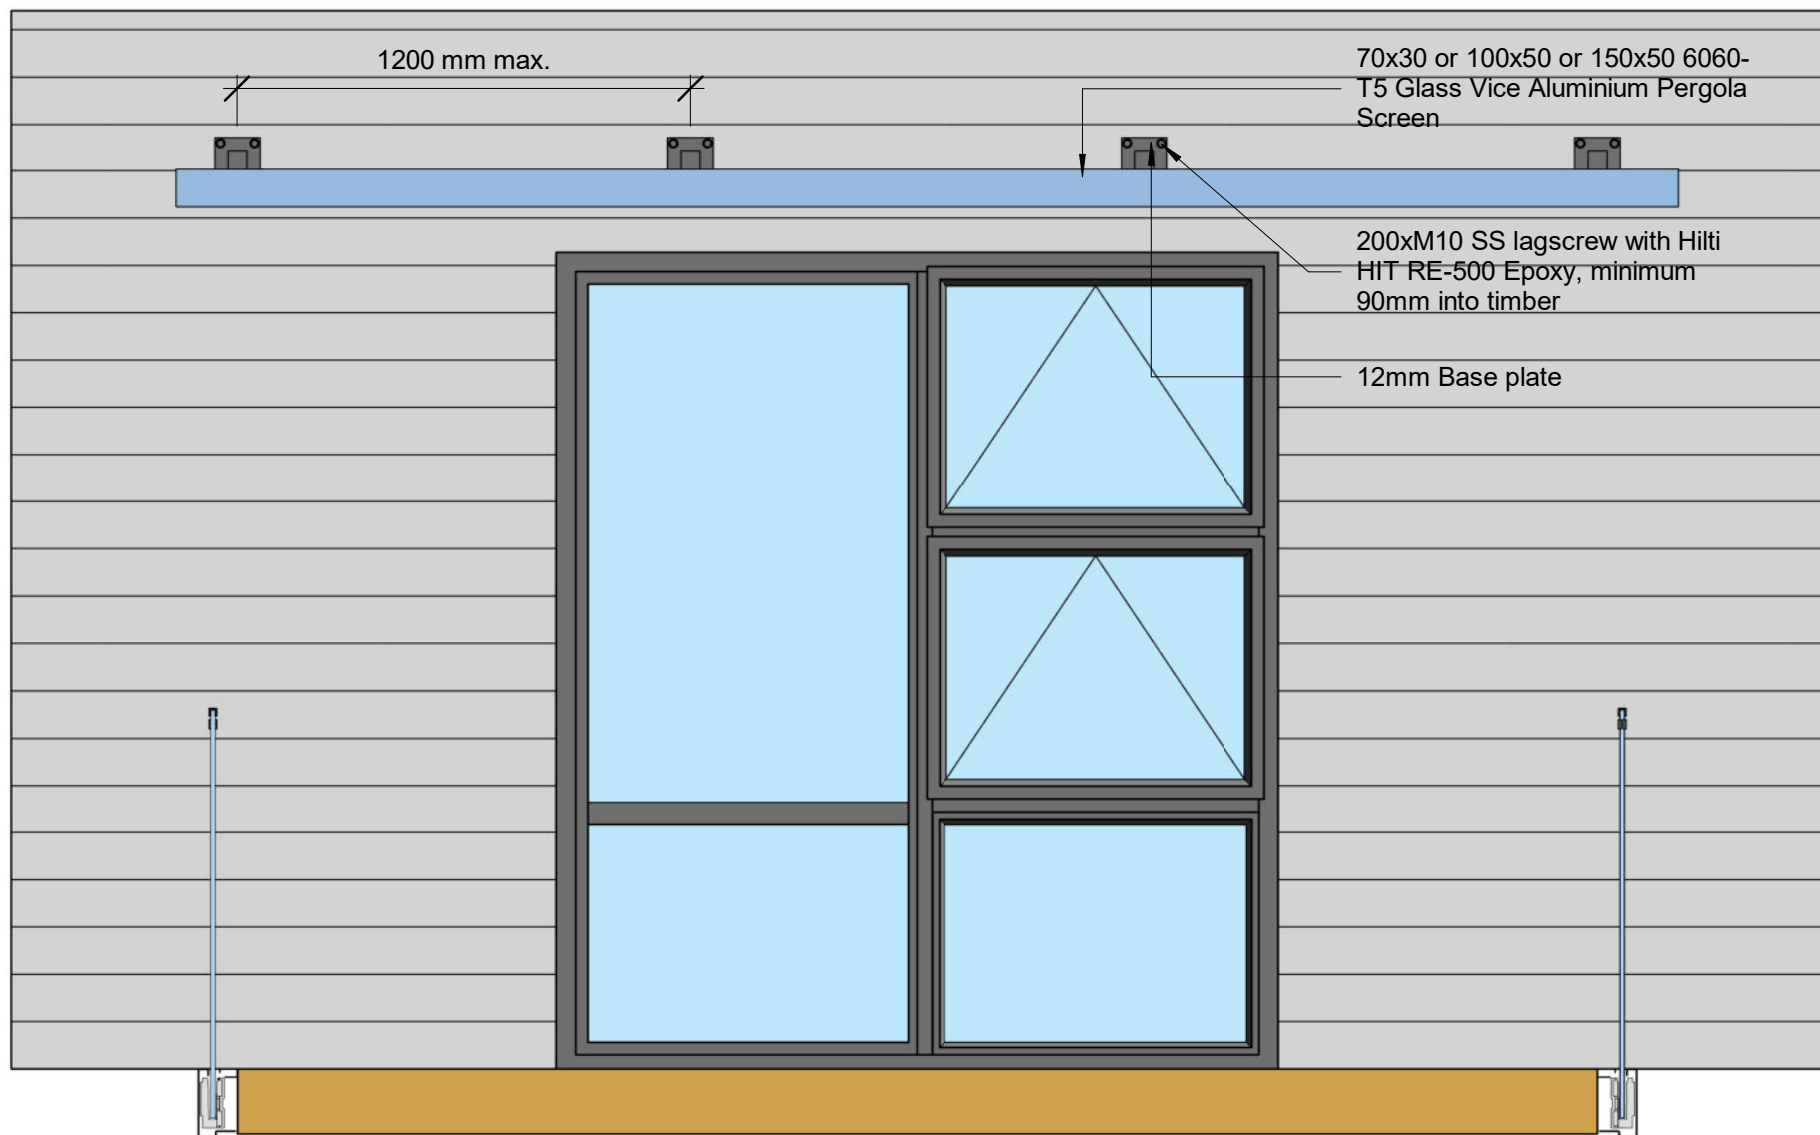

These drawings relate only to the Glass Vice Floating Timber Deck framing and its fixings. All other elements are shown indicative only.

© 2021. The copyright of this document is the property of Glass Vice Limited and shall not be reproduced, copied, loaned or disposed of directly, or indirectly, nor used for any purpose other than that for which it is specifically furnished without prior consent.



# Glass Vice Pergolas and Screens

Pergola


Ceiling Rails - Section

Date: Nov 2021  
Scale: 1 : 20  
Draft E

Quick Code:

gv\_pergola\_ktaldt.rvt  
All dimensions in millimetres  
www.glassvice.com  
Phone +64 9 414 6565  
info@glassvice.com

GV\_PER\_330

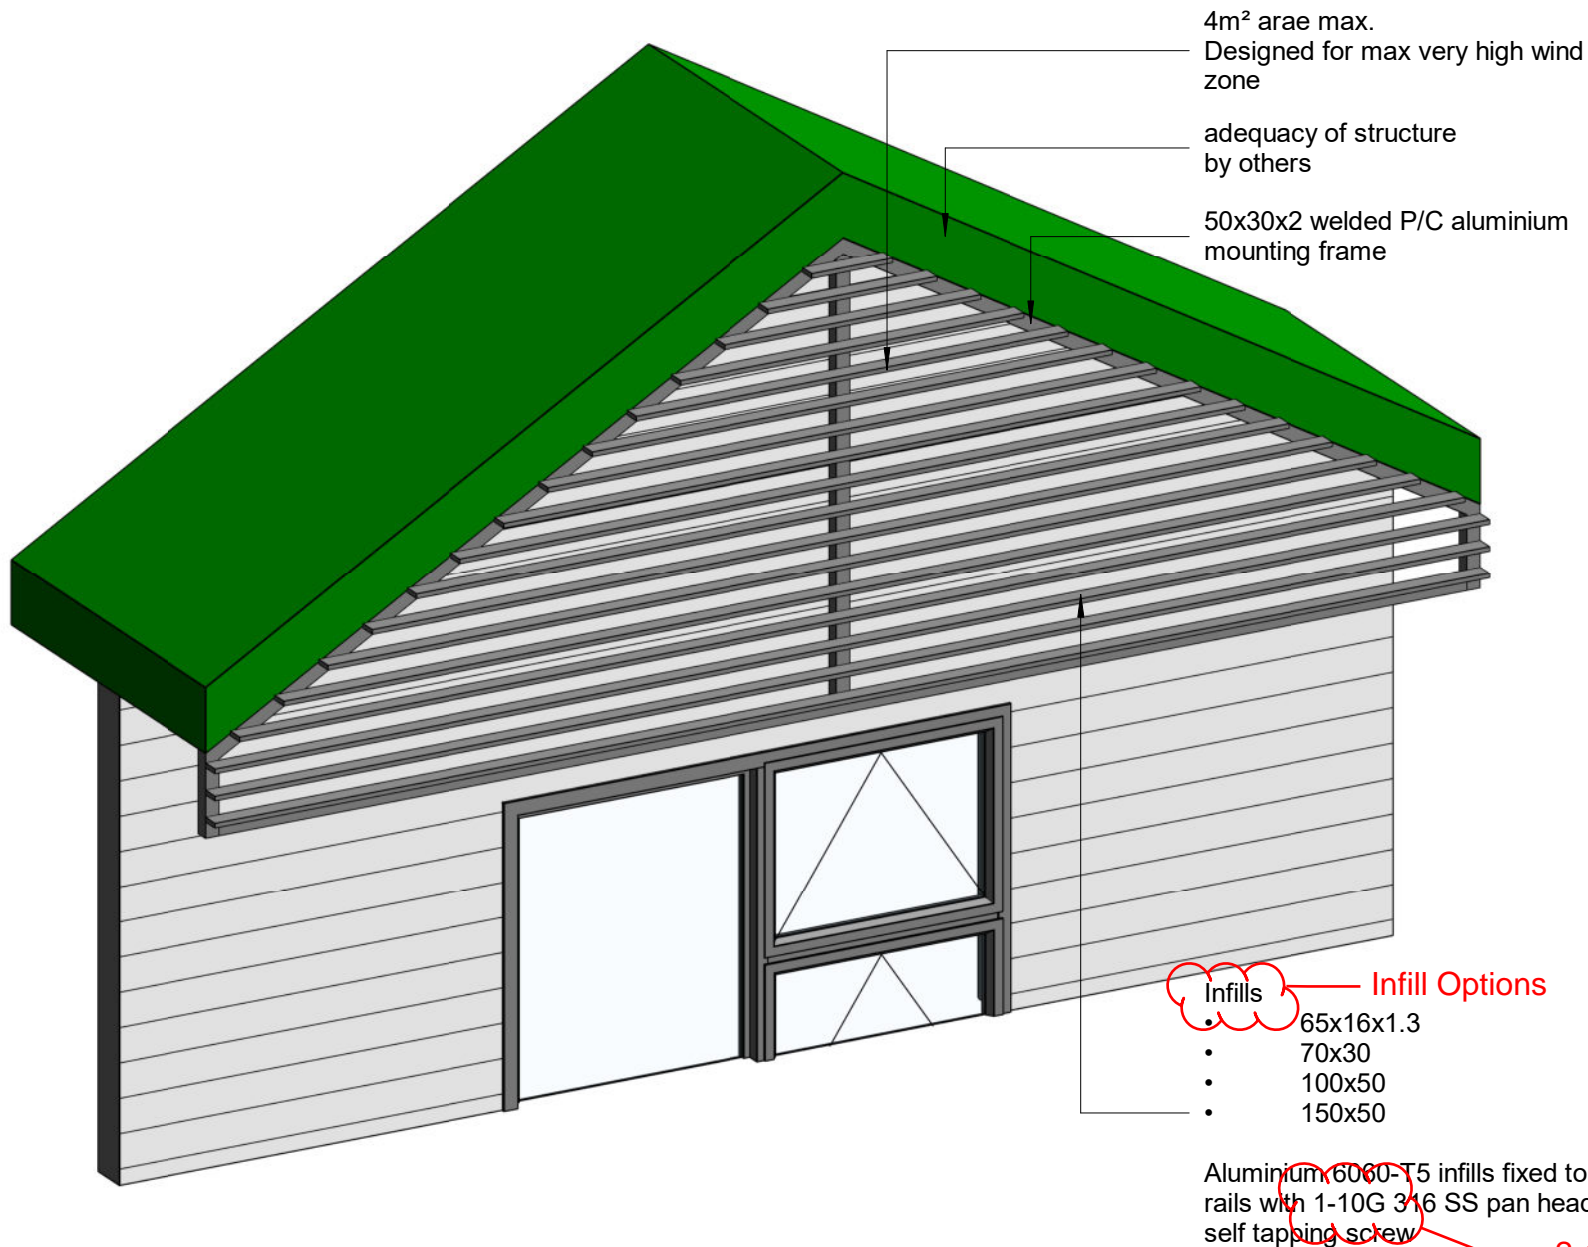

These drawings relate only to the Glass Vice Floating Timber Deck framing and its fixings. All other elements are shown indicative only.

© 2021. The copyright of this document is the property of Glass Vice Limited and shall not be reproduced, copied, loaned or disposed of directly, or indirectly, nor used for any purpose other than that for which it is specifically furnished without prior consent.



# Glass Vice Pergolas and Screens


Pergola  
Gable Screen

Date: Nov 2021  
Scale:  
Draft E

Quick Code:

gv\_pergola\_ktald.rvt  
All dimensions in millimetres  
www.glassvice.com  
Phone +64 9 414 6565  
info@glassvice.com

GV\_PER\_400

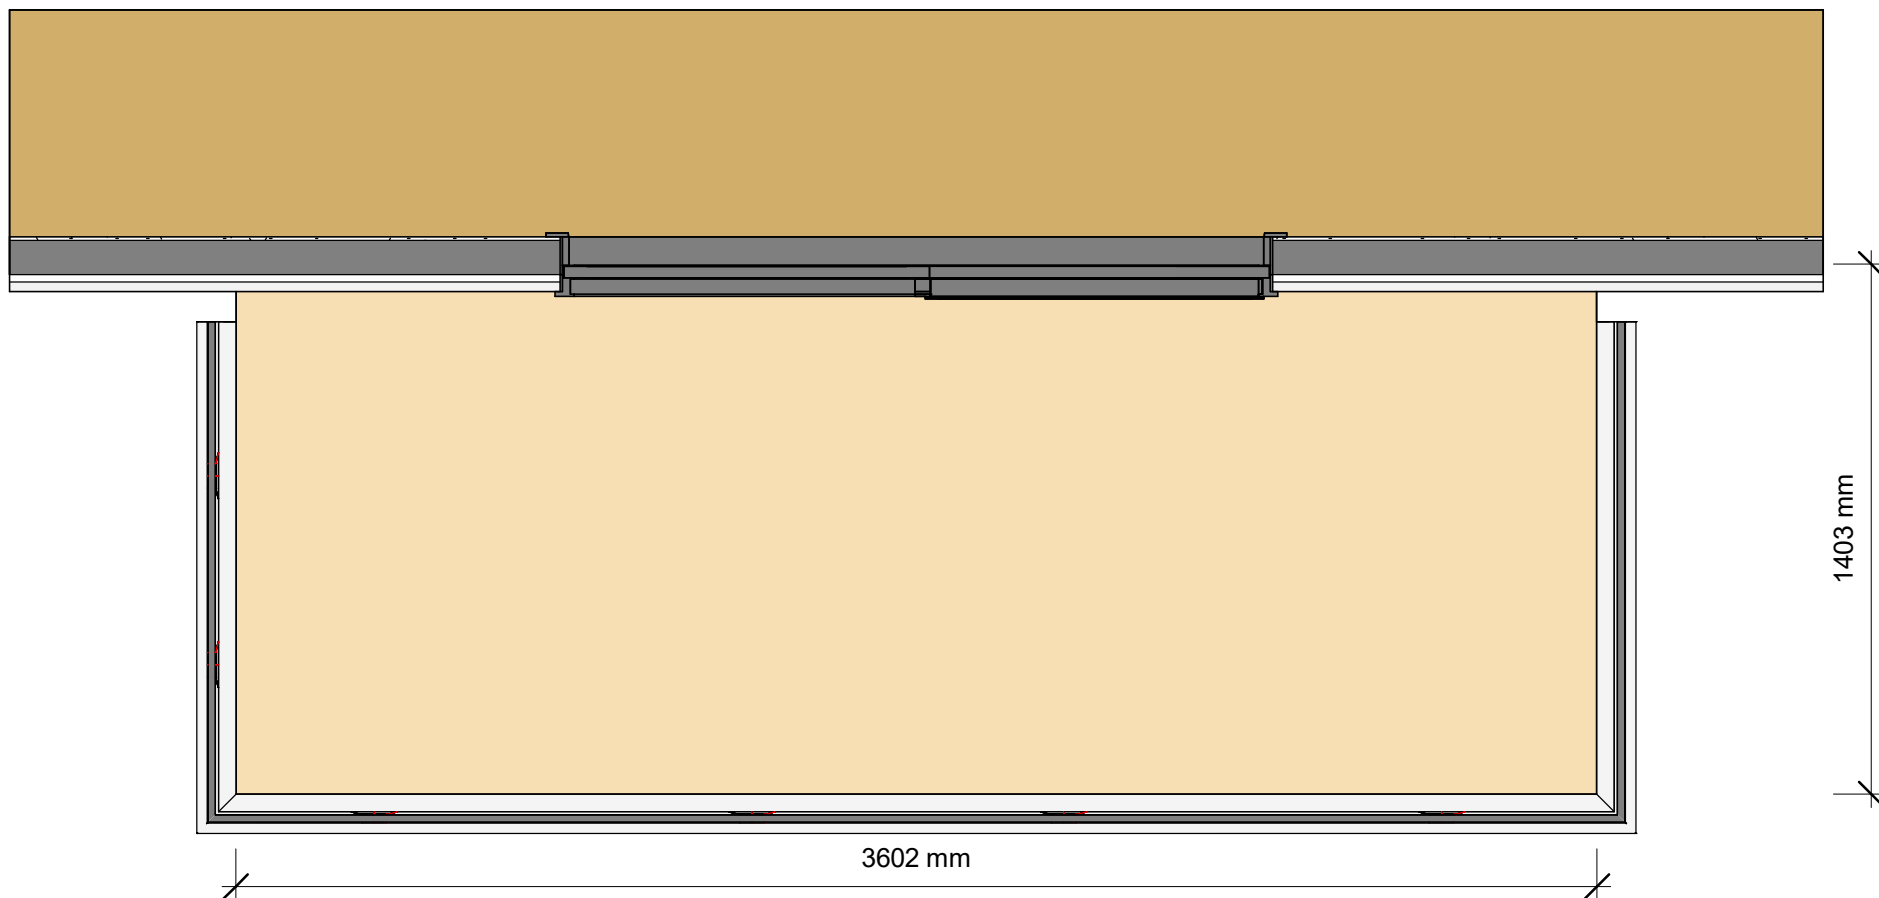

These drawings relate only to the Glass Vice Floating Timber Deck framing and its fixings. All other elements are shown indicative only.

© 2021. The copyright of this document is the property of Glass Vice Limited and shall not be reproduced, copied, loaned or disposed of directly, or indirectly, nor used for any purpose other than that for which it is specifically furnished without prior consent.

gv\_pergola\_ktalt.d.rvt  
All dimensions in millimetres



# Glass Vice Pergolas and Screens

Pergola  
Gable Screen


Date: Nov 2021  
Scale: 1 : 20  
Draft E

Quick Code:

www.glassvice.com  
Phone +64 9 414 6565  
info@glassvice.com

**GV\_PER\_410**



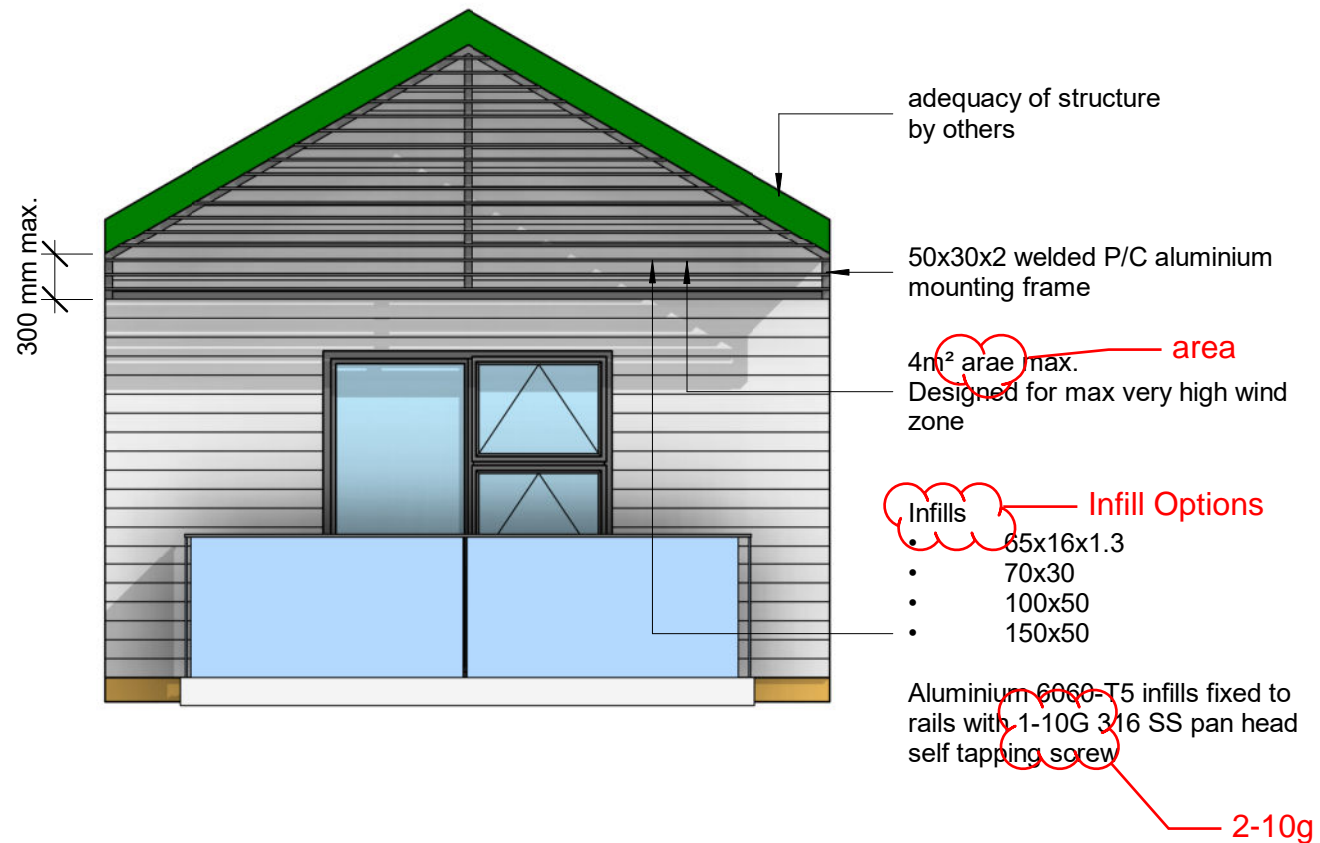

These drawings relate only to the Glass Vice Floating Timber Deck framing and its fixings. All other elements are shown indicative only.

© 2021. The copyright of this document is the property of Glass Vice Limited and shall not be reproduced, copied, loaned or disposed of directly, or indirectly, nor used for any purpose other than that for which it is specifically furnished without prior consent.



# Glass Vice Pergolas and Screens

Pergola

Gable Screen - Elevation

Date: Nov 2021  
Scale: 1 : 50  
Draft E

Quick Code:

gv\_pergola\_ktald.rvt  
All dimensions in millimetres  
www.glassvice.com  
Phone +64 9 414 6565  
info@glassvice.com

GV\_PER\_420

## Infill Options

### Infills

- 65x16x1.3
- 70x30
- 100x50
- 150x50

Aluminium 6060-T5 infills fixed to rails with 1-10G 816 SS pan head self tapping screw


2-10g

adequacy of structure by others

50x30x2 welded P/C aluminium mounting frame

4m<sup>2</sup> area max.

Designed for max very high wind zone

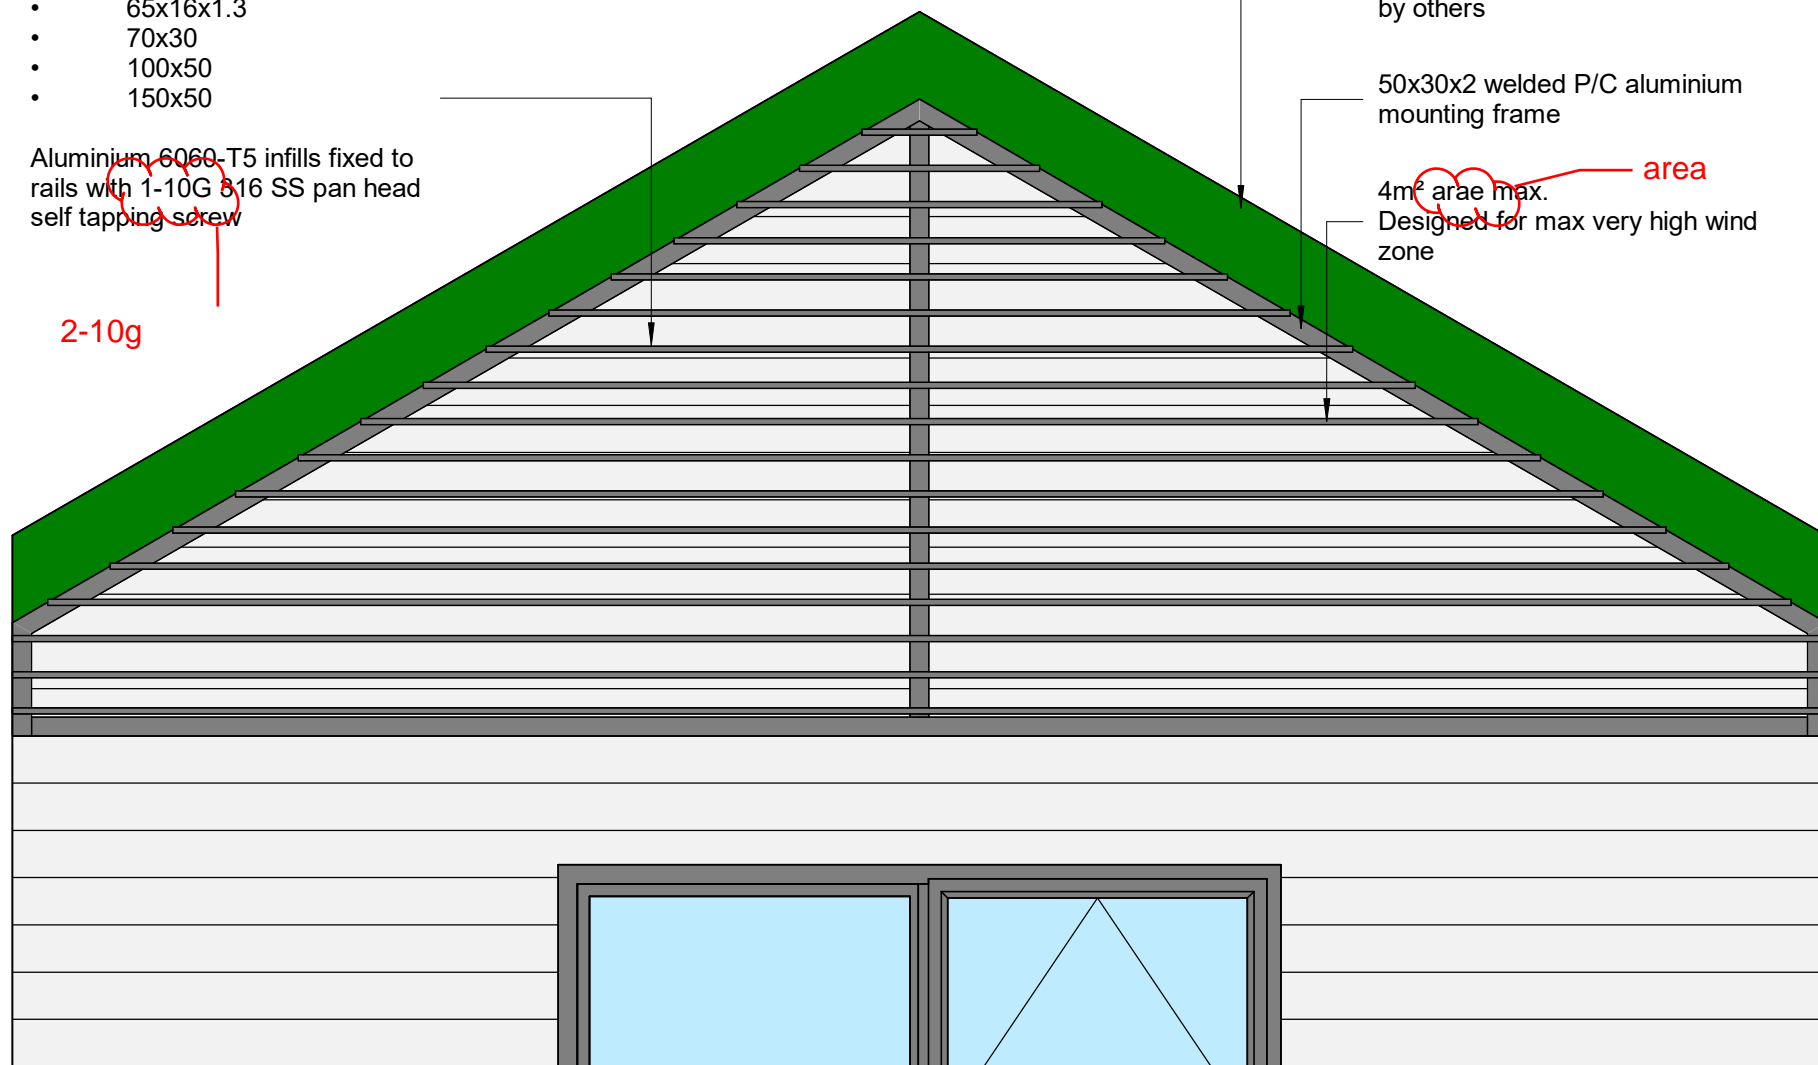

These drawings relate only to the Glass Vice Floating Timber Deck framing and its fixings. All other elements are shown indicative only.

© 2021. The copyright of this document is the property of Glass Vice Limited and shall not be reproduced, copied, loaned or disposed of directly, or indirectly, nor used for any purpose other than that for which it is specifically furnished without prior consent.



# Glass Vice Pergolas and Screens

Pergola

Gable Screen - Section


Date: Nov 2021  
Scale: 1 : 20  
Draft E

Quick Code:


gv\_pergola\_ktaldt.rvt  
All dimensions in millimetres  
www.glassvice.com  
Phone +64 9 414 6565  
info@glassvice.com

GV\_PER\_430


50x30x2 frame 6060 - T5

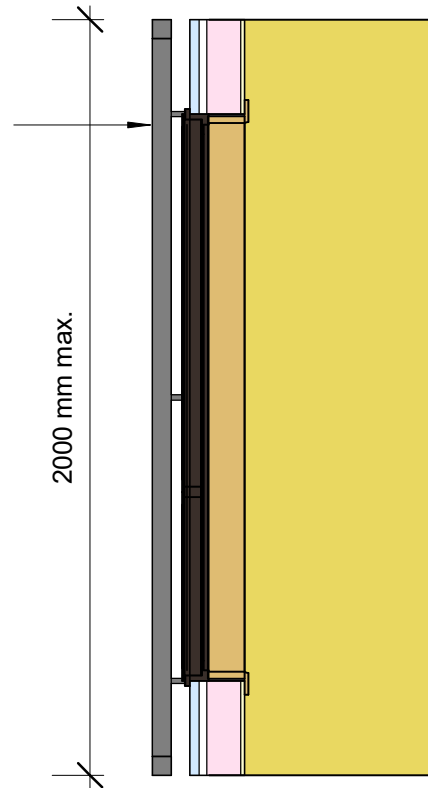

2 gv\_scr\_700 screen frame\_2  
1:20

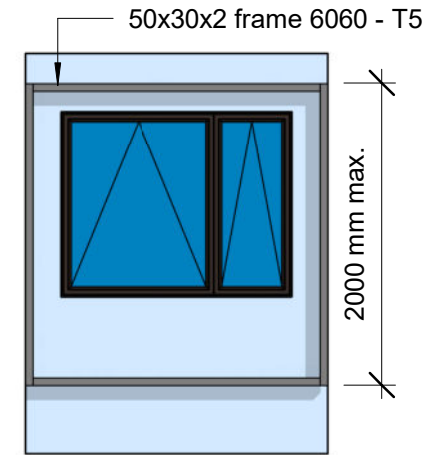

3 gv\_scr\_700 screen frame\_3  
1:50

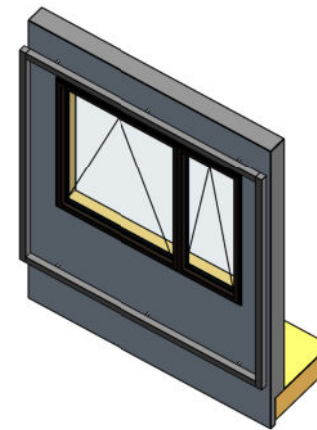

1 gv\_scr\_700 screen frame\_1

These drawings relate only to the Glass Vice Floating Timber Deck framing and its fixings. All other elements are shown indicative only.

© 2021. The copyright of this document is the property of Glass Vice Limited and shall not be reproduced, copied, loaned or disposed of directly, or indirectly, nor used for any purpose other than that for which it is specifically furnished without prior consent.



# Glass Vice Pergolas and Screens

## Pergola

### Screen Frame

Date: Nov 2021  
Scale: As indicated  
Draft E


Quick Code:

gv\_pergola\_ktald.rvt  
All dimensions in millimetres

www.glassvice.com  
Phone +64 9 414 6565  
info@glassvice.com

**GV\_SCR\_700**



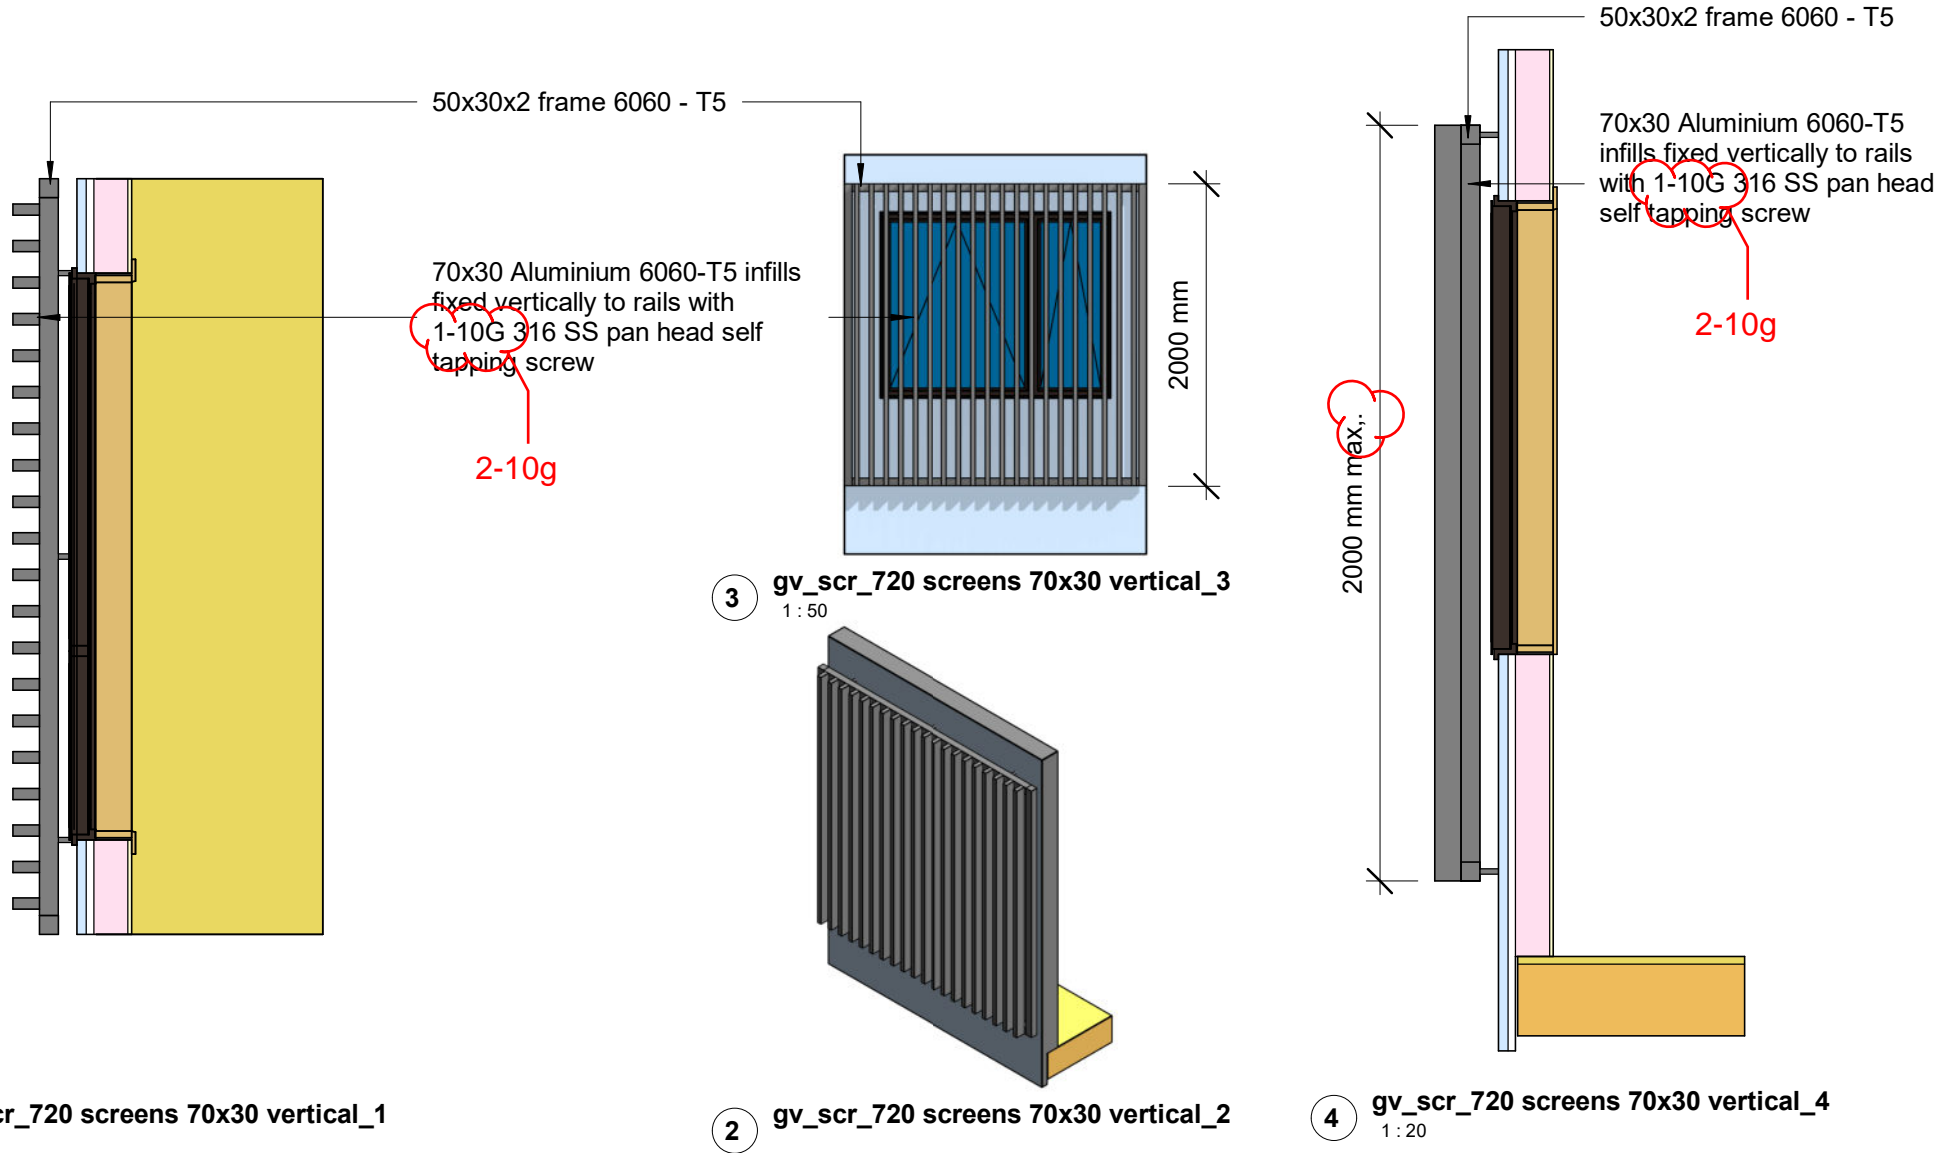

These drawings relate only to the Glass Vice Floating Timber Deck framing and its fixings. All other elements are shown indicative only.

© 2021. The copyright of this document is the property of Glass Vice Limited and shall not be reproduced, copied, loaned or disposed of directly, or indirectly, nor used for any purpose other than that for which it is specifically furnished without prior consent.



# Glass Vice Pergolas and Screens

Pergola

Screens 70x30 Vertical


Date: Nov 2021  
Scale: As indicated  
Draft E

Quick Code:

gv\_pergola\_ktaldt.rvt  
All dimensions in millimetres

www.glassvice.com  
Phone +64 9 414 6565  
info@glassvice.com

GV\_SCR\_720

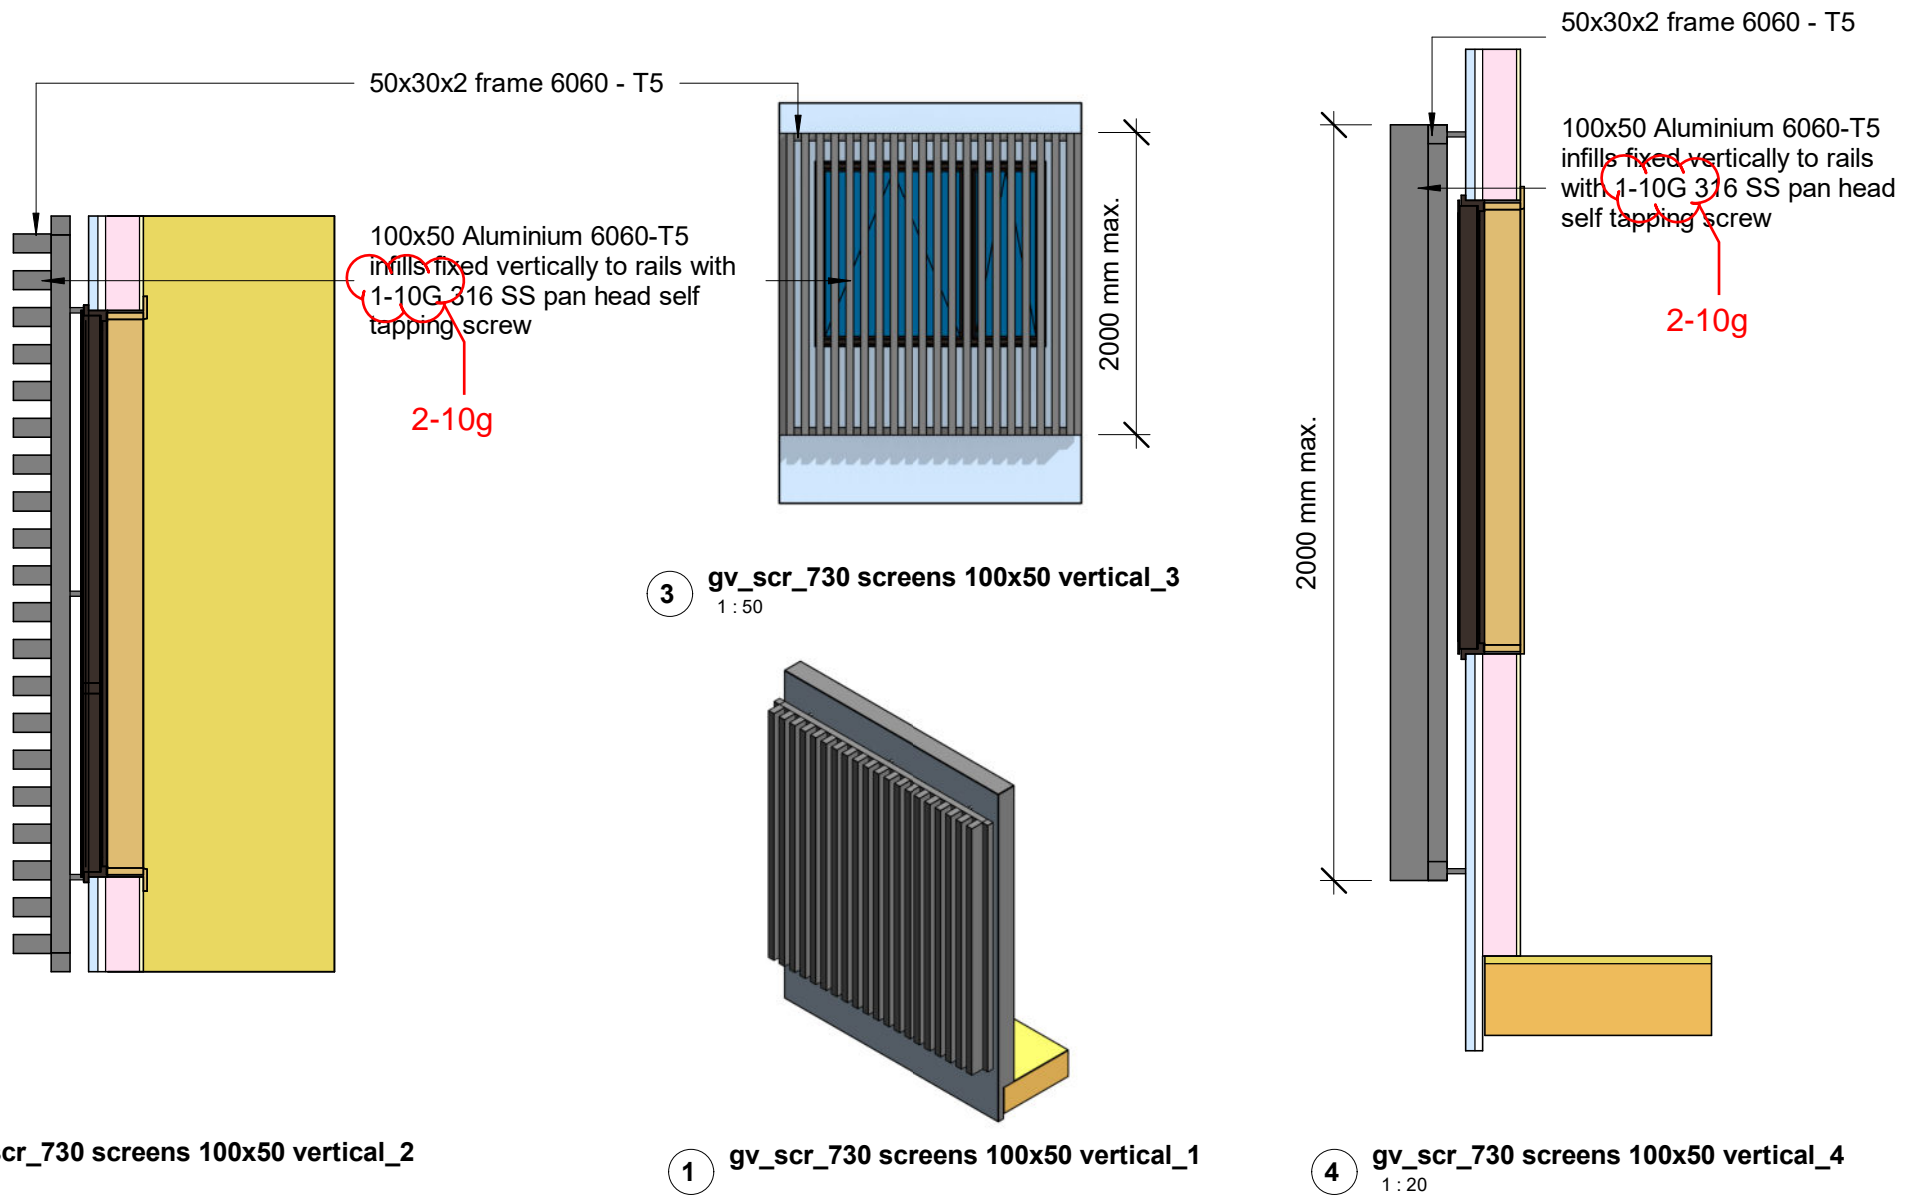

These drawings relate only to the Glass Vice Floating Timber Deck framing and its fixings. All other elements are shown indicative only.

© 2021. The copyright of this document is the property of Glass Vice Limited and shall not be reproduced, copied, loaned or disposed of directly, or indirectly, nor used for any purpose other than that for which it is specifically furnished without prior consent.



# Glass Vice Pergolas and Screens

Pergola


Screens 100x50 Vertical

Date: Nov 2021  
Scale: As indicated  
Draft E


Quick Code:

gv\_pergola\_ktaldt.rvt  
All dimensions in millimetres  
www.glassvice.com  
Phone +64 9 414 6565  
info@glassvice.com


GV\_SCR\_730

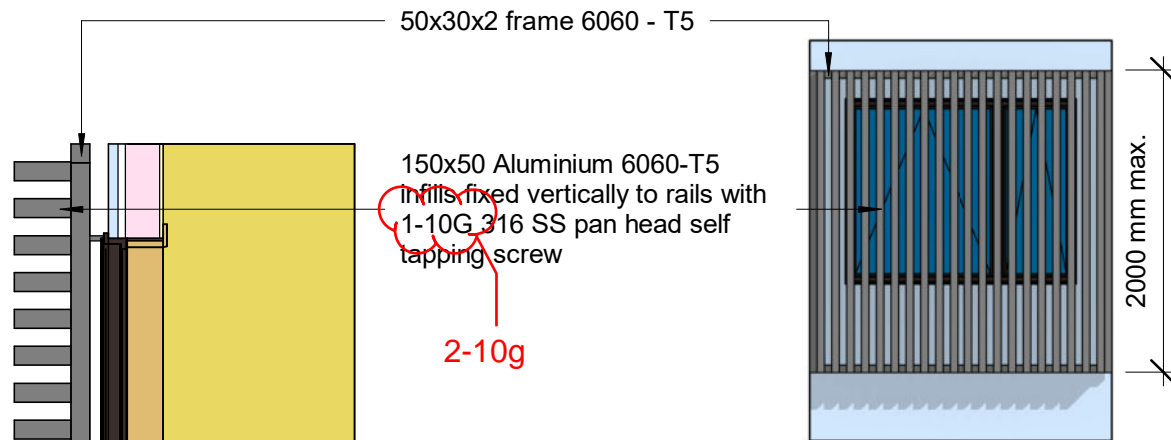

③ gv\_scr\_740 screens 150x50 vertical\_3  
1:50

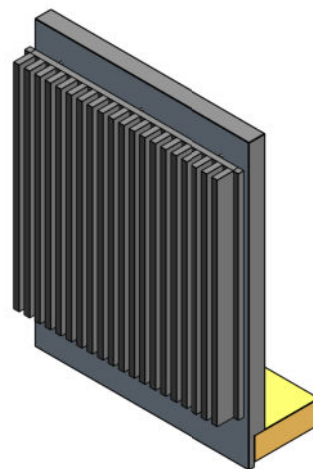

② gv\_scr\_740 screens 150x50 vertical\_2

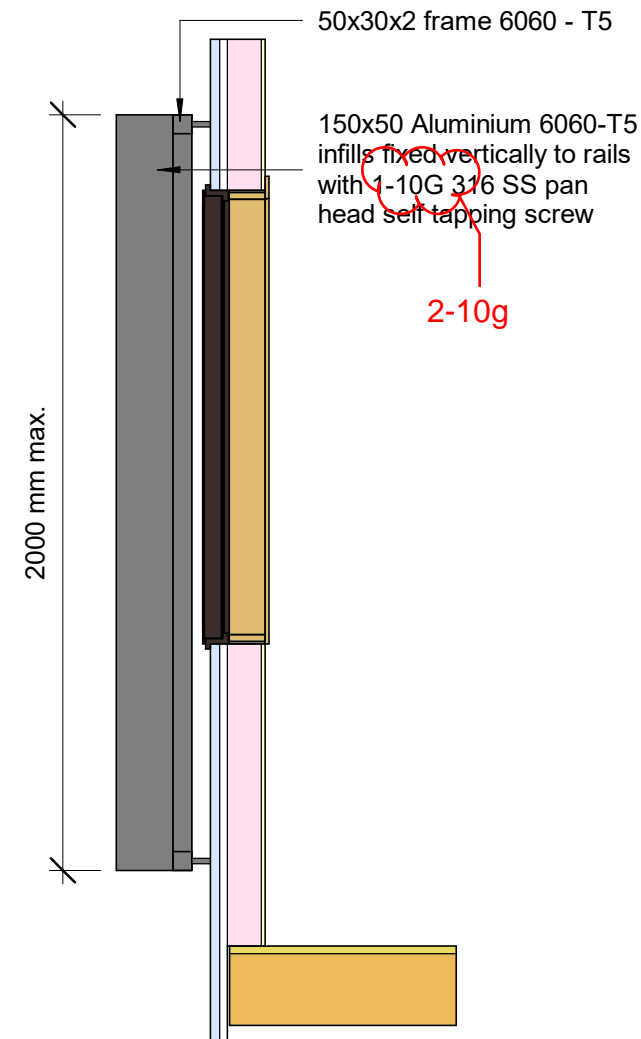

④ gv\_scr\_740 screens 150x50 vertical\_4  
1:20

① gv\_scr\_740 screens 150x50 vertical\_1  
1:20

These drawings relate only to the Glass Vice Floating Timber Deck framing and its fixings. All other elements are shown indicative only.

© 2021. The copyright of this document is the property of Glass Vice Limited and shall not be reproduced, copied, loaned or disposed of directly, or indirectly, nor used for any purpose other than that for which it is specifically furnished without prior consent.



# Glass Vice Pergolas and Screens

Pergola


Screens 150x50 Vertical

Date: Nov 2021  
Scale: As indicated  
Draft E


Quick Code:

gv\_pergola\_ktaldt.rvt  
All dimensions in millimetres  
www.glassvice.com  
Phone +64 9 414 6565  
info@glassvice.com


GV\_SCR\_740

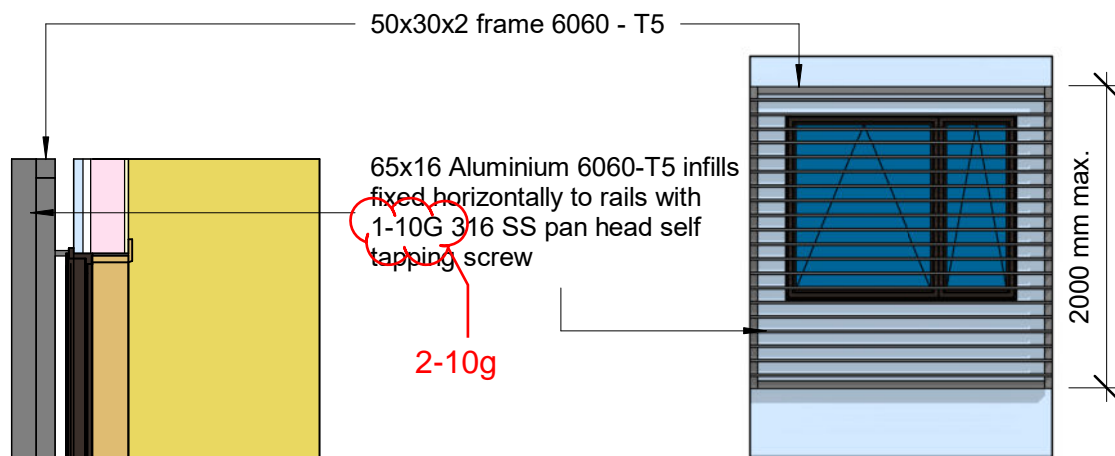

② gv\_scr\_810 screens 65x16 horizontal\_2  
1 : 50

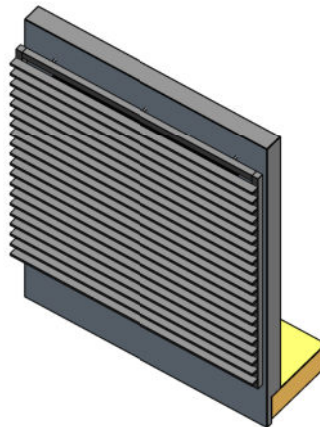

③ gv\_scr\_810 screens 65x16 horizontal\_3

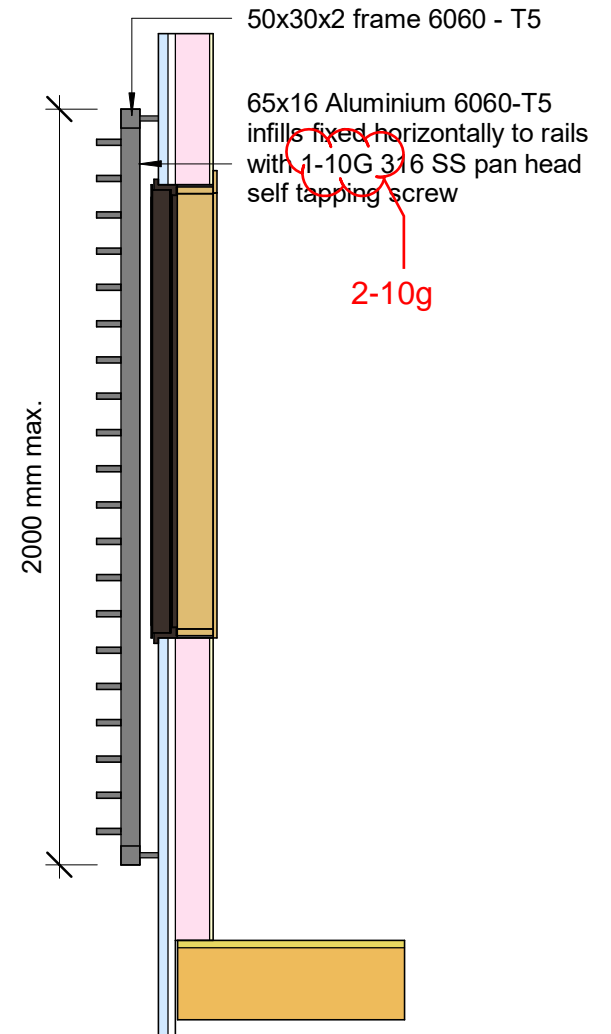

④ gv\_scr\_810 screens 65x16 horizontal\_4  
1 : 20

① gv\_scr\_810 screens 65x16 horizontal\_1  
1 : 20

These drawings relate only to the Glass Vice Floating Timber Deck framing and its fixings. All other elements are shown indicative only.

© 2021. The copyright of this document is the property of Glass Vice Limited and shall not be reproduced, copied, loaned or disposed of directly, or indirectly, nor used for any purpose other than that for which it is specifically furnished without prior consent.



# Glass Vice Pergolas and Screens

Pergola

Screens 65x16 Horizontal

Date: Nov 2021  
Scale: As indicated  
Draft E


Quick Code:

gv\_pergola\_ktald.rvt  
All dimensions in millimetres

www.glassvice.com  
Phone +64 9 414 6565  
info@glassvice.com


GV\_SCR\_810



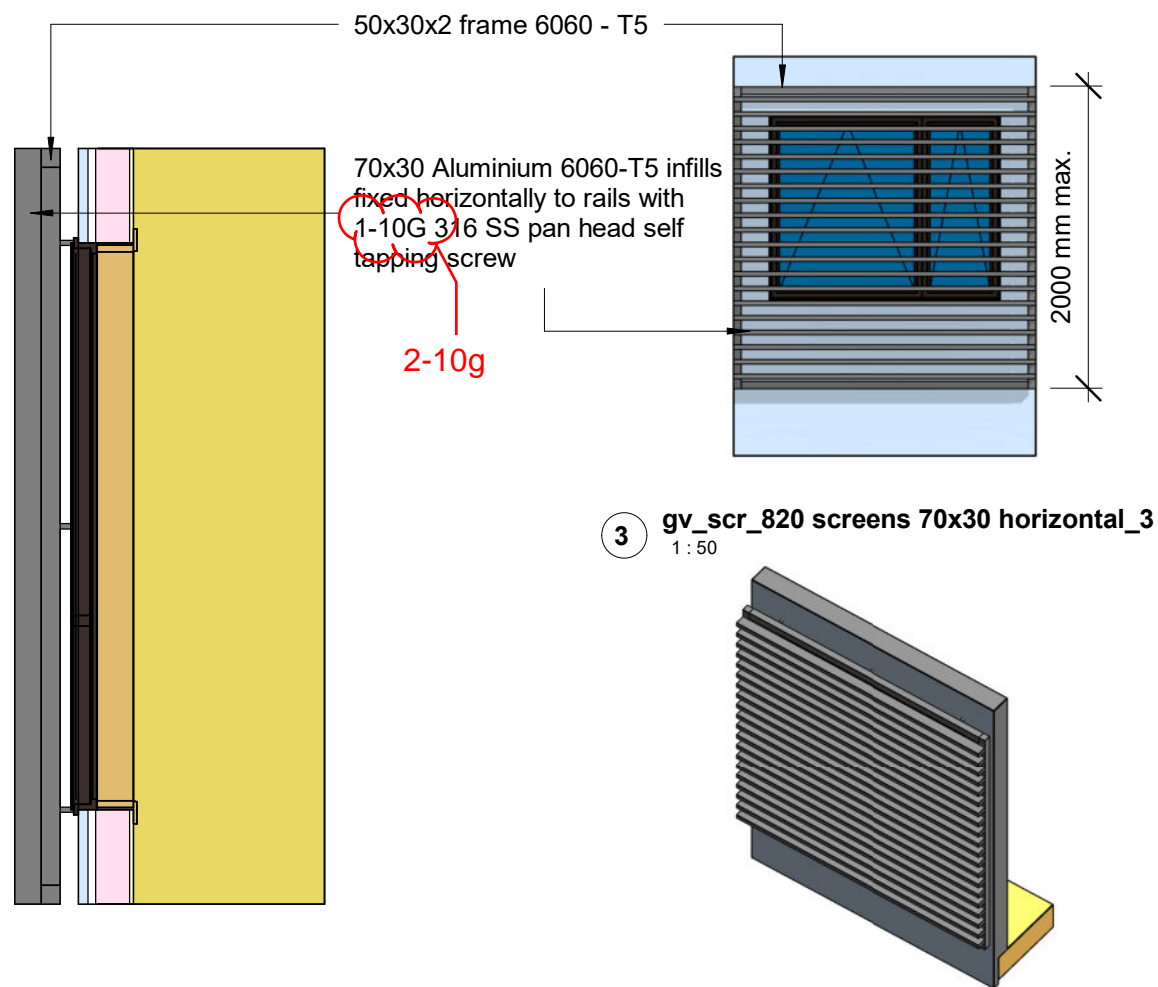

1 gv\_scr\_820 screens 70x30 horizontal\_1  
1:20

2 gv\_scr\_820 screens 70x30 horizontal\_2

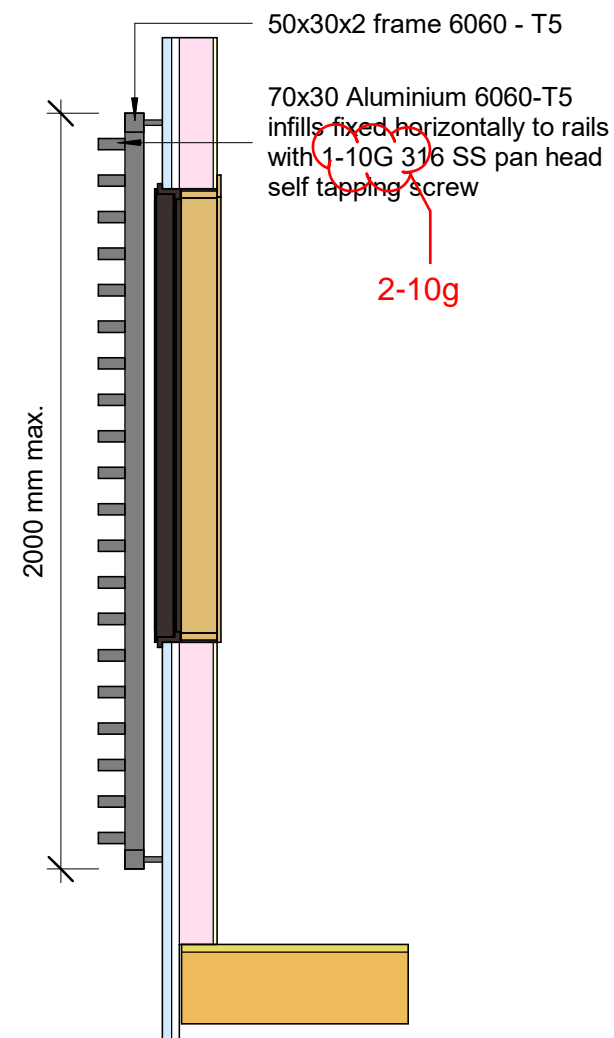

These drawings relate only to the Glass Vice Floating Timber Deck framing and its fixings. All other elements are shown indicative only.

© 2021. The copyright of this document is the property of Glass Vice Limited and shall not be reproduced, copied, loaned or disposed of directly, or indirectly, nor used for any purpose other than that for which it is specifically furnished without prior consent.



# Glass Vice Pergolas and Screens

Pergola


Screens 70x30 Horizontal

Date: Nov 2021  
Scale: As indicated  
Draft E


Quick Code:

gv\_pergola\_ktald.rvt  
All dimensions in millimetres  
www.glassvice.com  
Phone +64 9 414 6565  
info@glassvice.com

GV\_SCR\_820

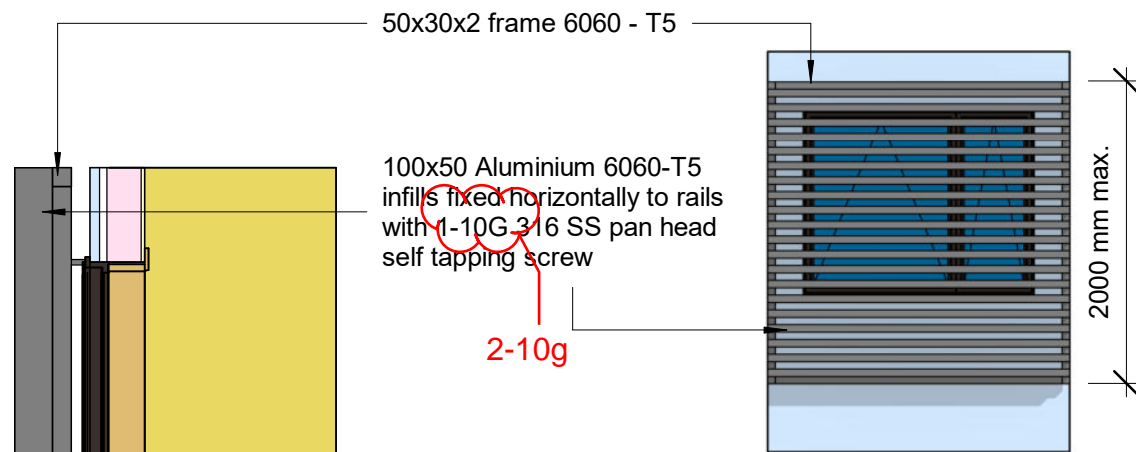


3 gv\_scr\_830 screens 100x50 horizontal\_3  
1 : 50

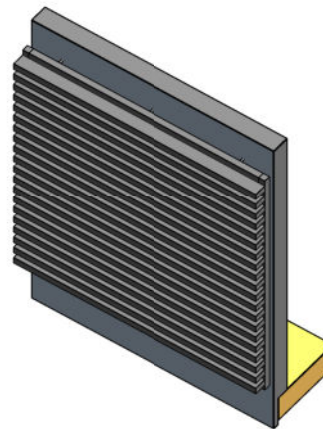

1 gv\_scr\_830 screens 100x50 horizontal\_1  
1 : 20

2 gv\_scr\_830 screens 100x50 horizontal\_2

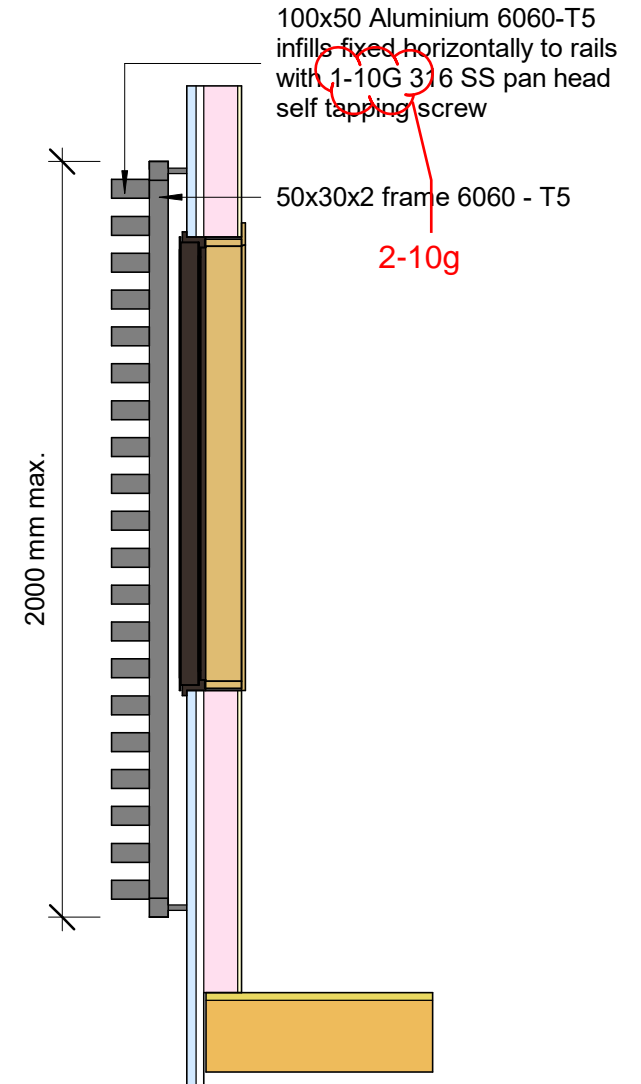

4 gv\_scr\_830 screens 100x50 horizontal\_4  
1 : 20

These drawings relate only to the Glass Vice Floating Timber Deck framing and its fixings. All other elements are shown indicative only.

© 2021. The copyright of this document is the property of Glass Vice Limited and shall not be reproduced, copied, loaned or disposed of directly, or indirectly, nor used for any purpose other than that for which it is specifically furnished without prior consent.



# Glass Vice Pergolas and Screens

Pergola



Screens 100x50 Horizontal

Date: Nov 2021  
Scale: As indicated  
Draft E

Quick Code:

gv\_pergola\_ktaldt.rvt  
All dimensions in millimetres  
www.glassvice.com  
Phone +64 9 414 6565  
info@glassvice.com

GV\_SCR\_830

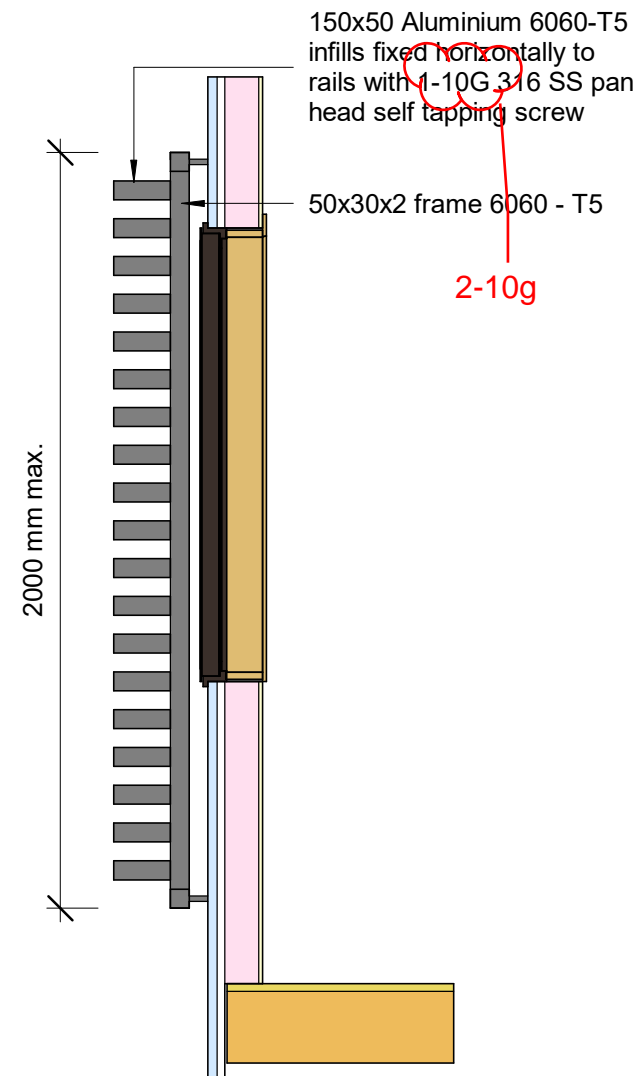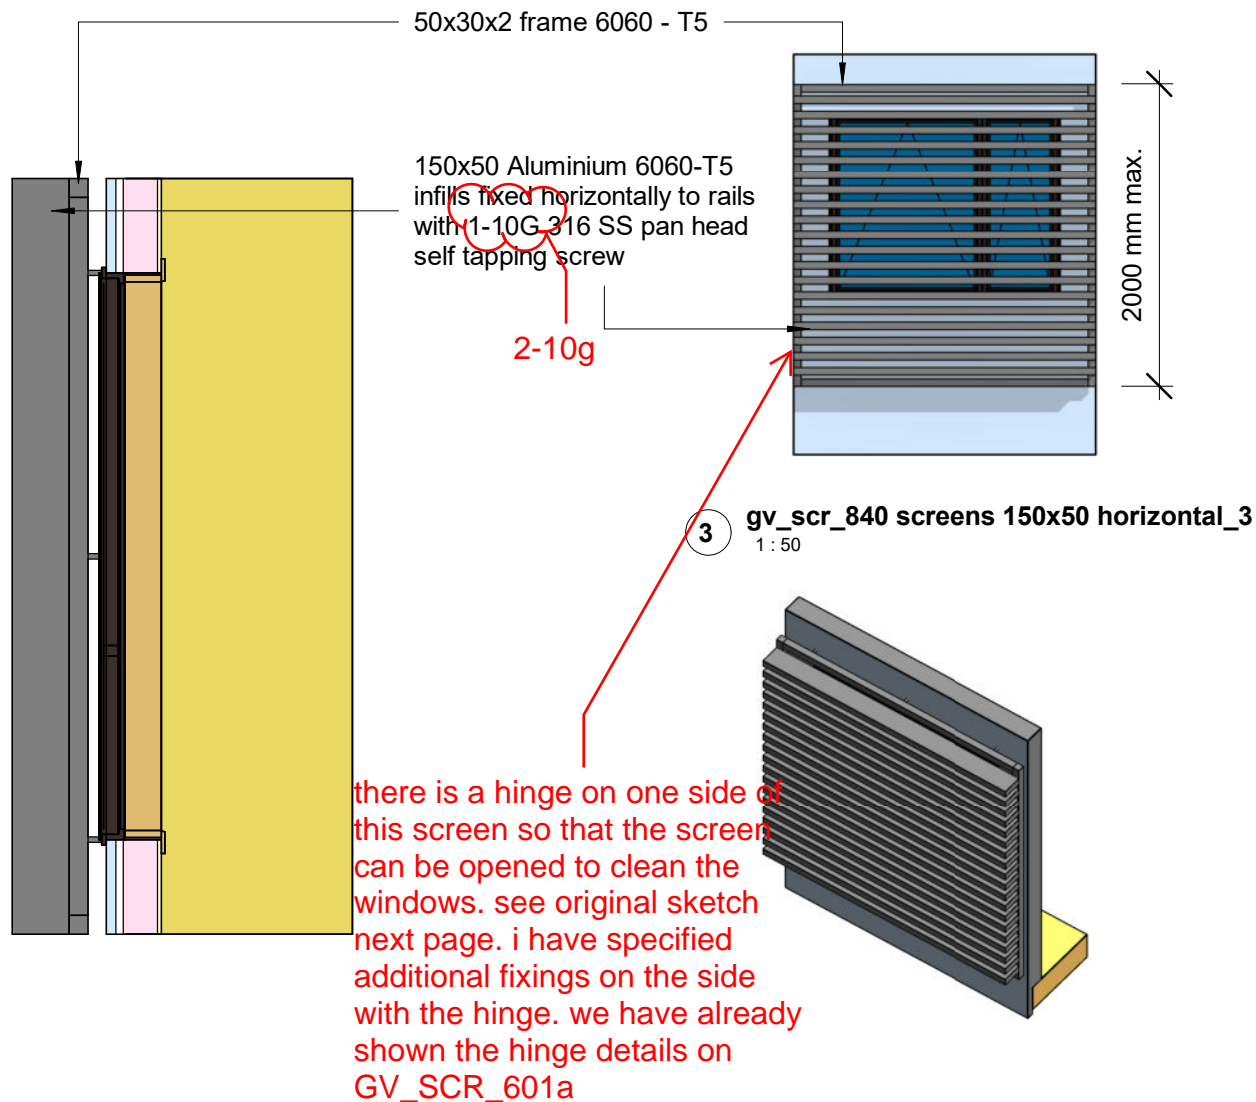

1 gv\_scr\_840 screens 150x50 horizontal\_1  
1:20

2 gv\_scr\_840 screens 150x50 horizontal\_2

4 gv\_scr\_840 screens 150x50 horizontal\_4  
1:20

These drawings relate only to the Glass Vice Floating Timber Deck framing and its fixings. All other elements are shown indicative only.

© 2021. The copyright of this document is the property of Glass Vice Limited and shall not be reproduced, copied, loaned or disposed of directly, or indirectly, nor used for any purpose other than that for which it is specifically furnished without prior consent.



# Glass Vice Pergolas and Screens

Pergola

Screens 150x50 Horizontal

Date: Nov 2021  
Scale: As indicated  
Draft E

Quick Code:

gv\_pergola\_ktald.rvt  
All dimensions in millimetres  
www.glassvice.com  
Phone +64 9 414 6565  
info@glassvice.com

GV\_SCR\_840

